


City of Prince George

HISTORY SHEET

354

SHEET NUMBER	No 1241	Roll Number
Legal:	LOT'S 13-14 BLOCK 5 D.L. 937	PLAN 752
Address:	728 HARPER STREET	
Sanitary Connection: #	4805 SIZE 100mm MATERIAL ACS INV.	CONNECTED
Water Connection #	1752 SIZE 20mm MATERIAL CU METER	CONNECTED
Storm Connection: #	SIZE MATERIAL INV.	CONNECTED
Cash Receipt No's:	WATER SANITARY 2759	STORM
CURB FROM PROPERTY LINE	4.811m	PAVEMENT WIDTH
B.C. HYDRO	OVERHEAD	UNDERGROUND CONNECTION
B.C. TELEPHONE	OVERHEAD	UNDERGROUND CONNECTION
INLAND GAS		
Information Sheets:		
Comments:		

SITE PLAN N.T.S.

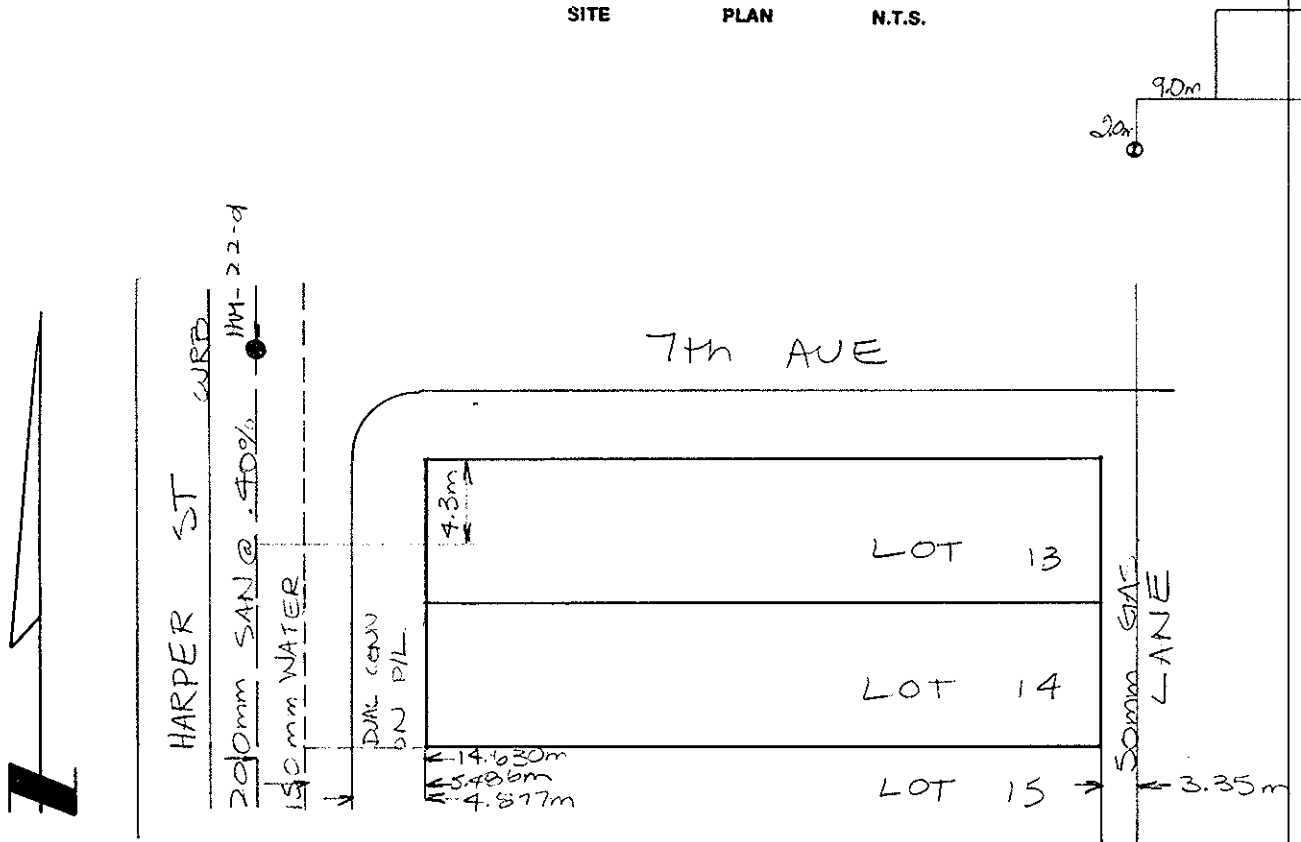


REPORT TO RECORDS

WATER SERVICE INFORMATION

Lot No. _____ Block _____ D.L. _____

Address 728. HarperSize of Connection ☐ ½" ☐ ¾" ☐ Other _____Type of Connection ☐ Copper ☐ IronThaw Wire ☐ Yes ☐ No

LOCATION SKETCH

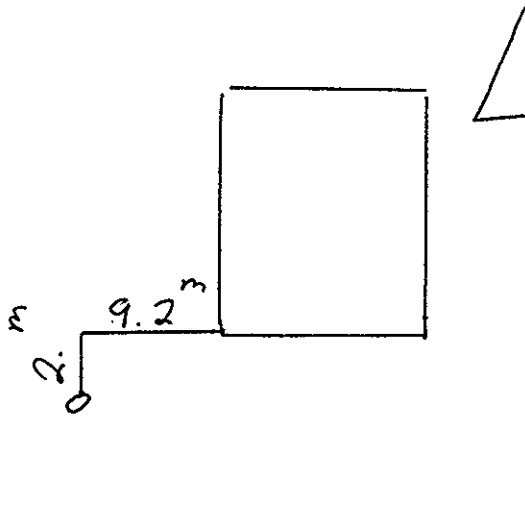Field Location By G.C. Date 11/6/92.

Checked by: _____