

**City of Prince George
HISTORY SHEET**

007809009
015

HM

SHEET NUMBER **N^o 2289** Roll Number

Legal: LOT'S **B-13-14** BLOCK **6** D.L. **937** PLAN **752**

Address: **706 IRWIN STREET**

Sanitary Connection: # **1967** SIZE **100mm** MATERIAL _____ INV. _____ **CONNECTED**

Water Connection # **949** SIZE **20mm** MATERIAL _____ METER _____ **CONNECTED**

Storm Connection: # _____ SIZE _____ MATERIAL _____ INV. _____ **CONNECTED**

Cash Receipt No's: WATER _____ SANITARY **385** STORM _____

CURB FROM PROPERTY LINE **4.877m** PAVEMENT WIDTH _____


B.C. HYDRO **OVERHEAD** UNDERGROUND CONNECTION _____

B.C. TELEPHONE **OVERHEAD** UNDERGROUND CONNECTION _____

INLAND GAS _____

Information Sheets:

Comments:

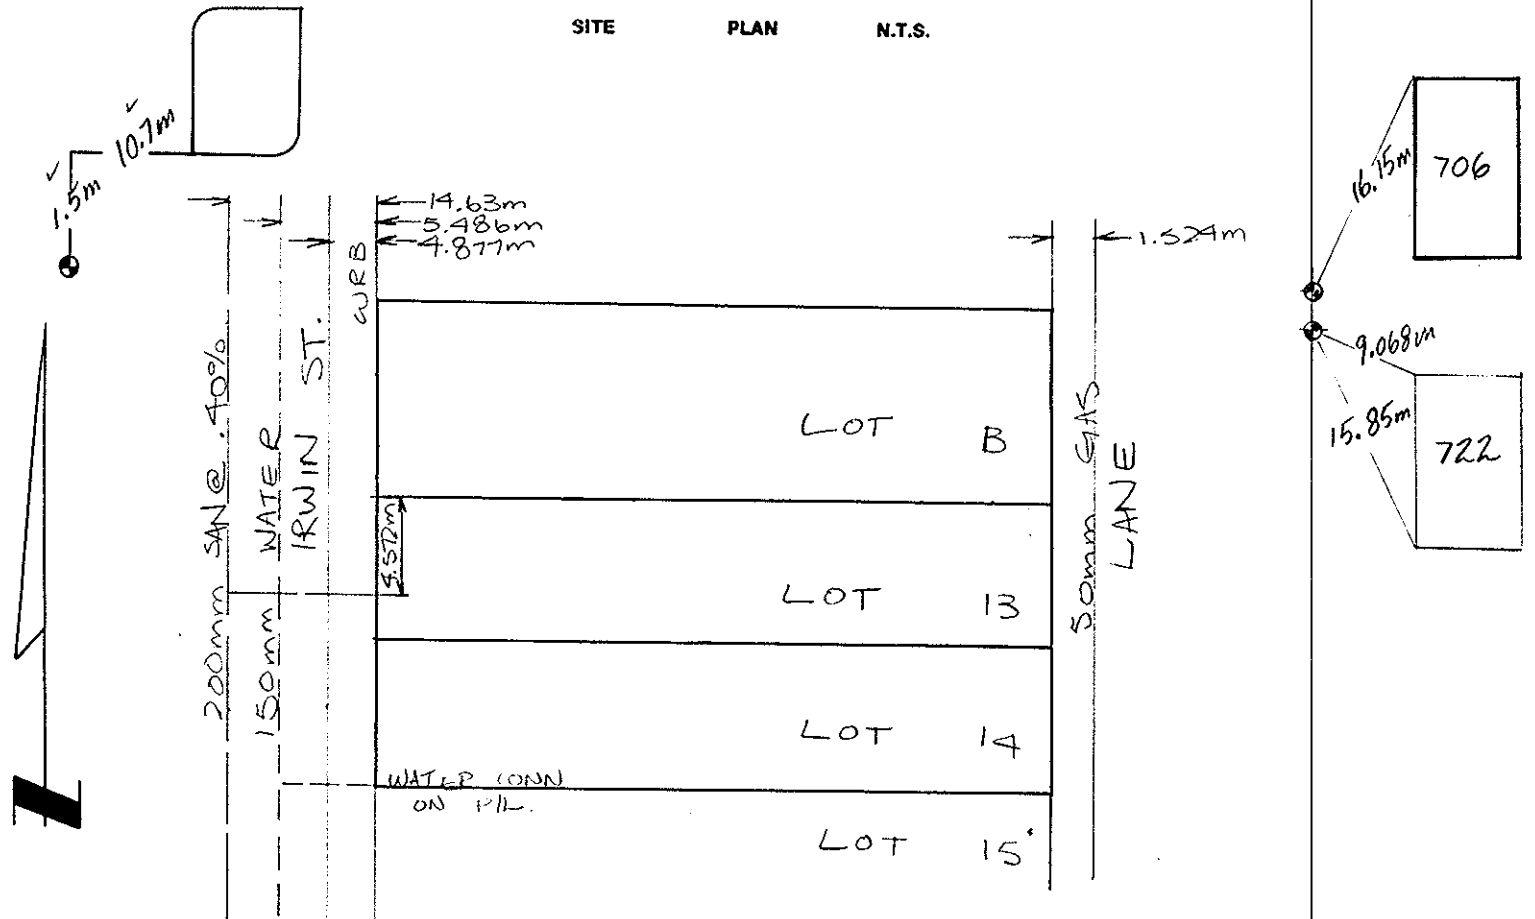

007807007

REPORT TO RECORDS

WATER SERVICE INFORMATION

Lot No. _____ Block _____ D.L. _____


Address 706 Irwin

Size of Connection 1/2" 3/4" Other _____

Type of Connection Copper Iron

Thaw Wire Yes No

LOCATION SKETCH

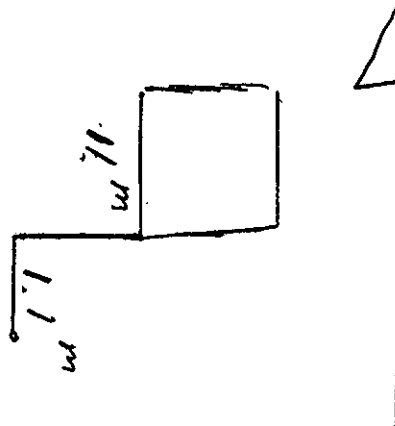

Field Location By G.C. Date 6/8/92

Checked by: _____