
City of Prince George

SHEET NUMBER		PID# 065	18/357/
Legal: LOTS 495 BLOG	DK .	D.L. 937 PLAN	15 185
Address: 751 Tay	LRES.		
Sanitary Connection: # 4945 si	ZE \ O O mm MATERIAL	A.C. INV. 601.223	CONNECTED
Water Connection: # 4945 si	ZE 20 mm MATERIAL	Cu. METER	CONNECTED
Storm Connection: # SI	ZE mm MATERIAL	INV.	CONNECTED
Cash Receipt No's: WATER PAID IN L	OT PRICE SANITARY FAI	DIN LOT PRICE STORM	
CURB FROM PROPERTY LINE 4.877 M		PAVEMENT WIDTH	10.363m
B.C. HYDRO V/G	UNDERGROI	UND CONNECTION	
B.C. TELEPHONE	UNDERGROU	UND CONNECTION	
INLAND GAS 3.657 M FROM	R		
Information Sheets:			

THE INFORMATION CONTAINED HEREIN IS FOR INTERNAL USE ONLY. NOT TO BE RELIED UPON UNLESS CONFIRMED BY SITE INSPECTION AND/OR INVESTIGATION



Comments:

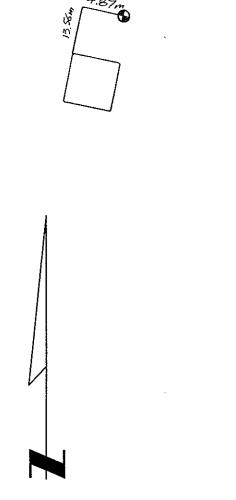