

**City of Prince George
HISTORY SHEET**

007850 9/3

5

SHEET NUMBER

Roll Number

930

Legal: LOT'S 2-3 BLOCK 73 D.L. 937 PLAN 752

Address: 373 N. NICHOLSON ST

Sanitary Connection: # 3246 SIZE 100 mm MATERIAL A.C. INV. 601.829 CONNECTED ✓

Water Connection # 3297 SIZE 20 mm MATERIAL CU. METER CONNECTED ✓

Storm Connection: # SIZE MATERIAL INV. CONNECTED

Cash Receipt No's: WATER SANITARY STORM

CURB FROM PROPERTY LINE 4.877 m PAVEMENT WIDTH 10.363 m

B.C. HYDRO 0/H UNDERGROUND CONNECTION

B.C. TELEPHONE 0/H UNDERGROUND CONNECTION


INLAND GAS 1.524 m FROM WEST SIDE OF LANE.

Information Sheets:

Comments: WITH THAW WIRE.



SITE PLAN N.T.S.

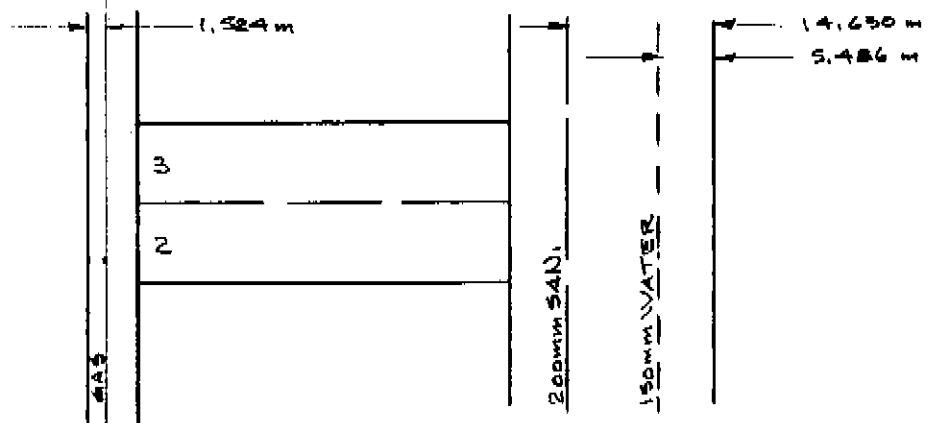

N. NICHOLSON ST.

