


100,000
043

City of Prince George HISTORY SHEET

SHEET NUMBER	N ^o 2346	Roll Number
Legal:	LOT'S 21-22 BLOCK 24	D.L. 937 PLAN 752
Address:	674 JOHNSON STREET	
Sanitary Connection: #	3777	SIZE MATERIAL INV. CONNECTED
Water Connection #	984	SIZE 13mm MATERIAL CU METER CONNECTED
Storm Connection: #		SIZE MATERIAL INV. CONNECTED
Cash Receipt No's:	WATER	SANITARY 1719 STORM
CURB FROM PROPERTY LINE	4.877m	PAVEMENT WIDTH
B.C. HYDRO	OVERHEAD	UNDERGROUND CONNECTION
B.C. TELEPHONE	OVERHEAD	UNDERGROUND CONNECTION
INLAND GAS		
Information Sheets:		
Comments:		

SITE PLAN N.T.S.

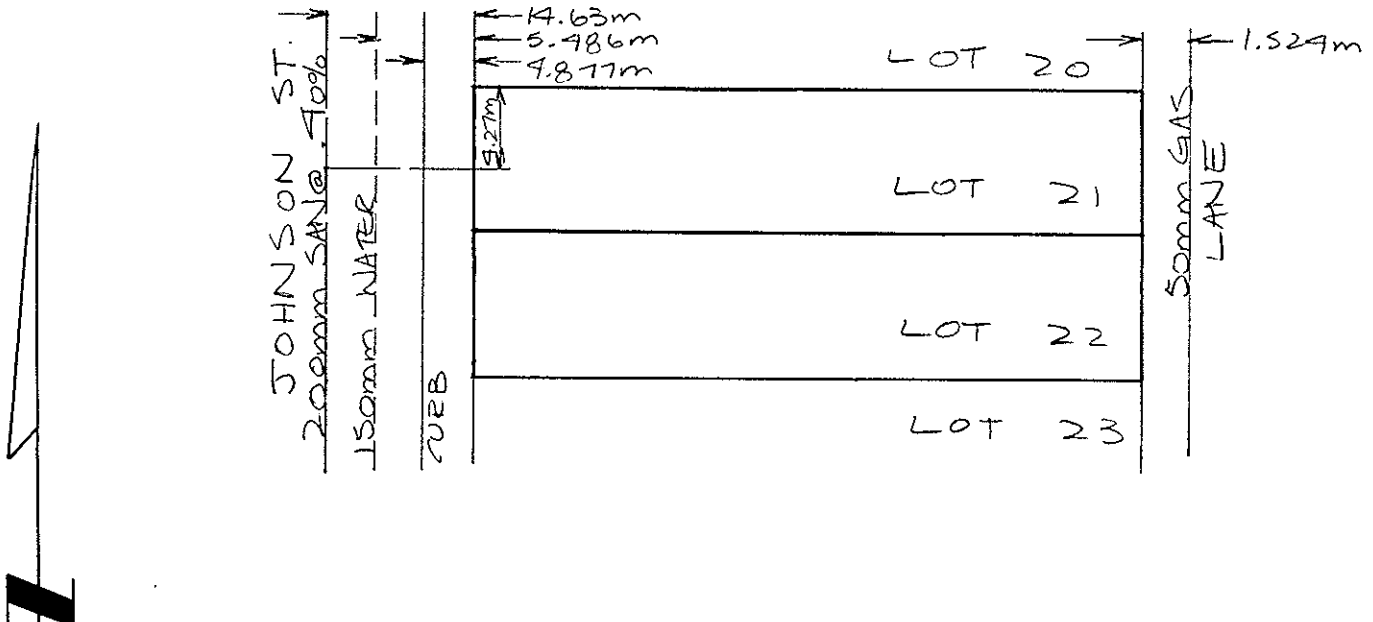

REPORT TO RECORDS

WATER SERVICE INFORMATION

Lot No. _____ Block _____ D.L. _____


Address 674 Johnson.

Size of Connection 1/2" 3/4" Other _____

Type of Connection Copper Iron

Thaw Wire Yes No

LOCATION SKETCH

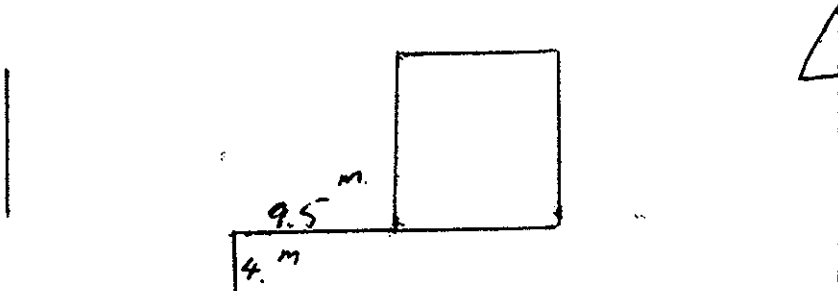

Field Location By G. Clayton. Date 6/8/92

Checked by: _____