
City of Prince George HISTORY SHEET

SHEET NUMBER Nº	2340		Roll Number		
Legal: LOT'S	9-10	BLOCK 29	D.L.	937	PLAN 752
Address:	623	IEWIN	STREET		
Sanitary Connection:	1531	SIZE	MATERIAL	INV.	CONNECTED
Water Connection #	983	SIZE 19 mm	MATERIAL	METER	CONNECTED
Storm Connection: #		SIZE	MATERIAL	inv.	CONNECTED
Cash Receipt No's:	WATER		SANITARY > 69	4	STORM
CURB FROM PROPERTY LINE	4.877m		PAVEMENT WIDTH		
B.C. HYDRO	OUERHEAD		UNDERGROUND CONNECTION		
B.C. TELEPHONE	OUEPHEAD		UNDERGROUND CONNECTION		
INLAND GAS					
Information Sheets:					
Comments:					
	, , , , , , , , , , , , , , , , , , , ,	SITE	PLAN N.T.S.		

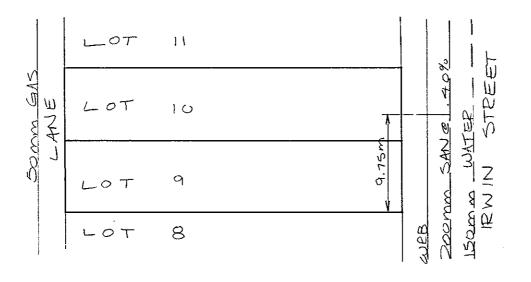

PLAN

N.T.S.

