



City of Prince George
History Sheet

PID:	007864311
	007864329
MU:	101973
WO:	99904/99905

Civic Address: 661, 663 Carney St

Legal Description: Lot: 4, 5 Block: 30 District Lot: 937 Plan: 752


Service Type	Diameter (mm)	Material	Invert Elev at main (m)	Invert Elev at property line (m)	Invert Elev at service end (m)	Distance into property (m)	Installation Date
Sanitary (S1)	100mm	PVC	587.08	587.11	587.13	1.10	June 2019
Sanitary (S2)	100mm	PVC	587.10	587.13	587.14	1.10	June 2019
Water (W1)	20mm	Copper	587.66	587.20	567.12	1.10	June 2019
Water (W2)	20mm	Copper	587.73	587.22	587.24	1.10	June 2019
Storm	N/A	N/A	-	-	-	-	

Service Connection Location				Sanitary (m)	Storm (m)
Distance from downstream San MH	2668	towards upstream San MH	2664	37.09	
Distance from downstream San MH	2668	towards upstream San MH	2664	44.30	

Power	Size	Communications	Size	Cable	Size	Gas	Size
BC Hydro	-	Telus	-	Shaw	-	FortisBC	-
Overhead Service		Overhead Service		Overhead Service			

Installed by:	City of Prince George forces	Survey Date:	-
Comments:			

NOT TO SCALE The information contained herein is for internal use only.
Not to be relied on unless confirmed by site inspection and/or investigation.

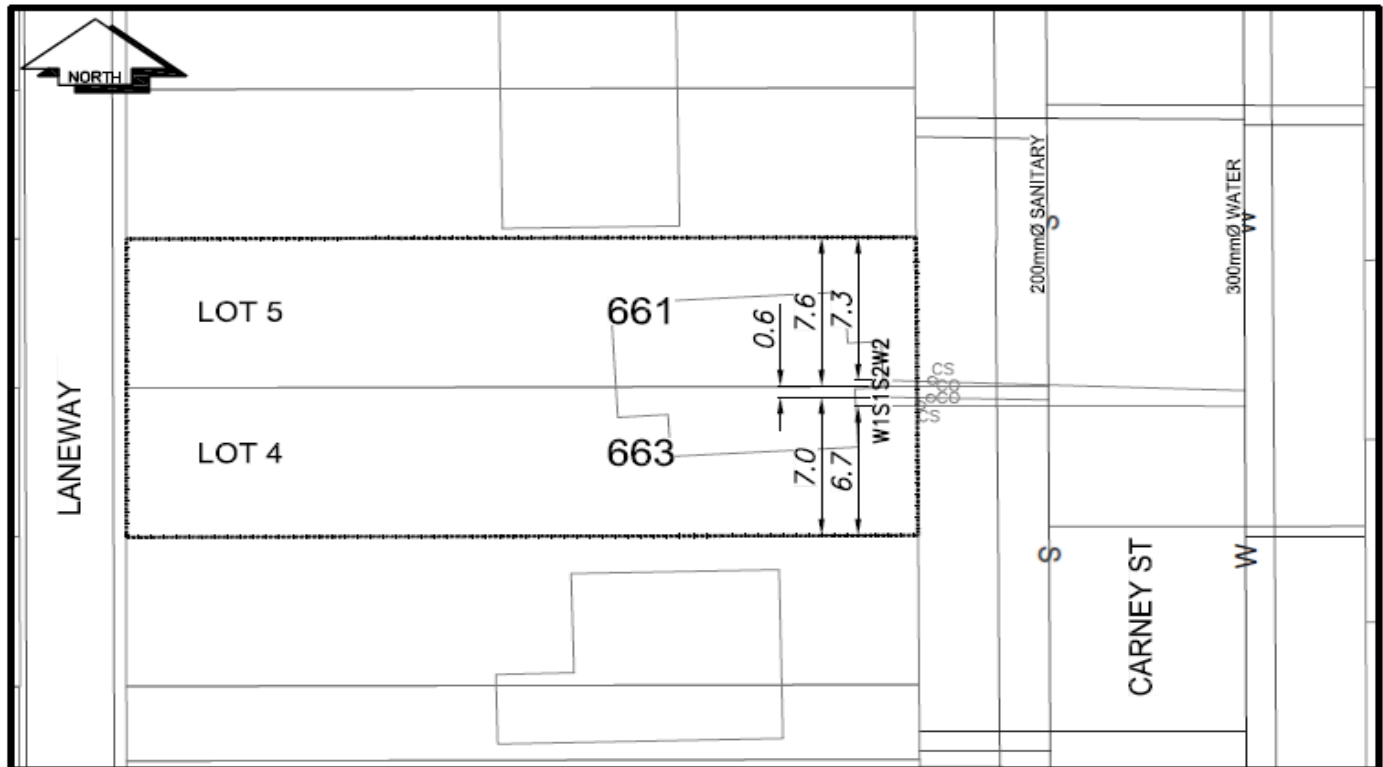

CS ^o CURB STOP	—W— WATER SERVICE	—S— STORM SERVICE
CO ^o CLEAN OUT	- - - - - SANITARY SERVICE	—G— GAS
⊗ WATER VALVE	—FH— FIRE HYDRANT	- - - - - ENCUMBRANCE

NOT TO SCALE