



City of Prince George
History Sheet

PID:	007864337
	007864353
SD/MU:	
WO:	5017365

Civic Address: 679 Gillett St

Legal Description: Lot: 3, 4 Block: 26 District Lot: 937 Plan: 752


Service Type	Diameter (mm)	Material	Invert Elev at main (m)	Invert Elev at property line (m)	Invert Elev at service end (m)	Distance into property (m)	Installation Date
Sanitary	100mm	AC	-	-	-	-	December 1959
Water (W1)	20mm	Copper	594.34	568.66	-	-	December 1959
Water (W2)	20mm	Copper	594.36	568.64	-	-	December 1959
Storm	N/A	N/A	-	-	-	-	

Service Connection Location			Sanitary (m)	Storm (m)
Distance from downstream San MH	-	towards upstream San MH	-	
Distance from downstream Stm MH	-	towards upstream Stm MH	-	

Power	Size	Communications	Size	Cable	Size	Gas	Size
BC Hydro	-	Telus	-	Shaw	-	FortisBC	-
Overhead Service		Overhead Service		Overhead Service			

Installed by:		Survey Date:	-
Comments:	Maintenance performed on water in March 2020		

NOT TO SCALE The information contained herein is for internal use only.
Not to be relied on unless confirmed by site inspection and/or investigation.

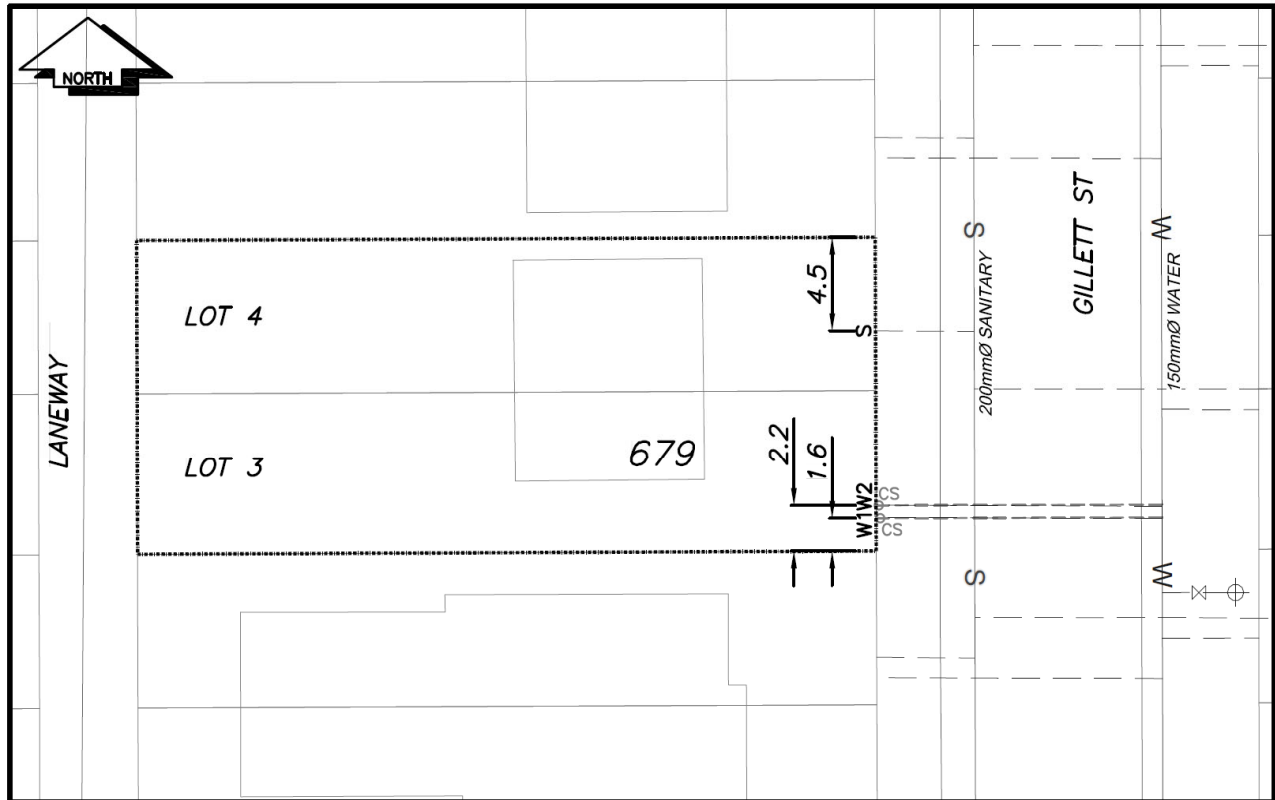

LEGEND:	
CS ^o	CURB STOP
CO ^o	CLEAN OUT
⊗	WATER VALVE
— —	WATER SERVICE
- - - - - -	SANITARY SERVICE
⊗	FIRE HYDRANT
—o—	STORM SERVICE
—G—	GAS
- - - - - -	ENCUMBRANCE

NOT TO SCALE