


Legal Description: Lot: 19 & North 15' of Lot 20 Block: 32 District Lot: 937 Plan: 752

Sanitary Water Storm	100 19	AC		1				perty (m)	Date	
	10		-	-		-		-	January 1961	
Storm	19	COPPER	-	-		-		-	January 1960	
	N/A	-	-	-		-		-	-	
Sanitary Service Connection Location Notes					Storm Service Connection Location Notes					
Distance from downstream SAN MH #2666: 51.42m					Distance from downstream STM MH #: N/A					
Distance to upstream SAN MH #981: 47.03m					Distance to upstream STM MH #: N/A					
			Mis	cellaned	ous Utilities					
Power		Communications			Cable			Gas		
BC Hydro		TELUS			Shaw Cable		FortisBC			
Overhead Se	0	Overhead Service		Overhead Service			Underground Service			
Installation By: Unknown						Draft Date:	2022-12-2	1 Survey Da	ate: -	
I				Comn	nents:				I	

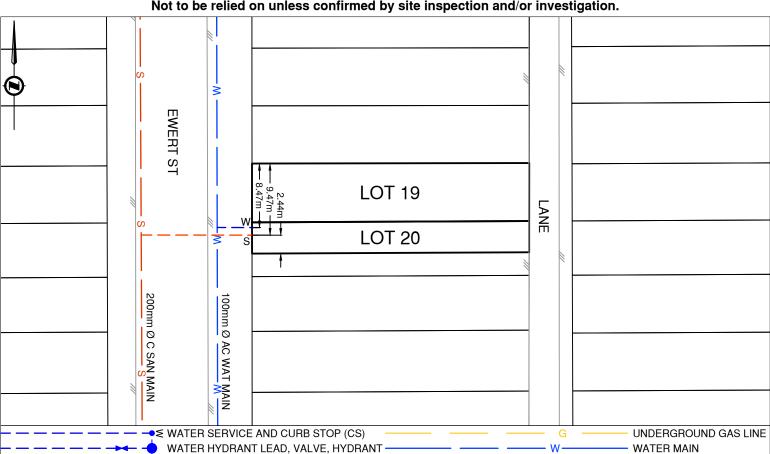

o SANITARY SERVICE AND CLEAN OUT (CO)

□ STORM SERVICE

ROAD EDGE

NOT TO SCALE The information contained herein is for internal use only. Not to be relied on unless confirmed by site inspection and/or investigation.

SANITARY MAIN

STORM MAIN

- ENCUMBRANCE

s -

D