



Lot Services Sketch

PID: 007892047

CITY OF PRINCE GEORGE

Civic Address: 540 EWERT ST

Legal Description: Lot: 17 Block: 32 District Lot: 937 Plan: 752

Service Type	Diameter (mm)	Material	Invert Elev @ Main (m)	Invert Elev @ Property Line (m)	Invert Elev @ Service End (m)	Distance into Property (m)	Installation Date
Sanitary	N/A	-	-	-	-	-	-
Water	N/A	-	-	-	-	-	-
Storm	N/A	-	-	-	-	-	-


Sanitary Service Connection Location Notes	Storm Service Connection Location Notes
Distance from downstream SAN MH #: N/A	Distance from downstream STM MH #: N/A
Distance to upstream SAN MH #: N/A	Distance to upstream STM MH #: N/A

Miscellaneous Utilities			
Power	Communications	Cable	Gas
BC Hydro	TELUS	Shaw Cable	FortisBC
Overhead Service	Overhead Service	Overhead Service	Underground Service

Installation By: -	Draft Date: 2022-12-21	Survey Date: -
--------------------	------------------------	----------------

Comments:
Lot 17 is not serviced.

**NOT TO SCALE The information contained herein is for internal use only.
Not to be relied on unless confirmed by site inspection and/or investigation.**

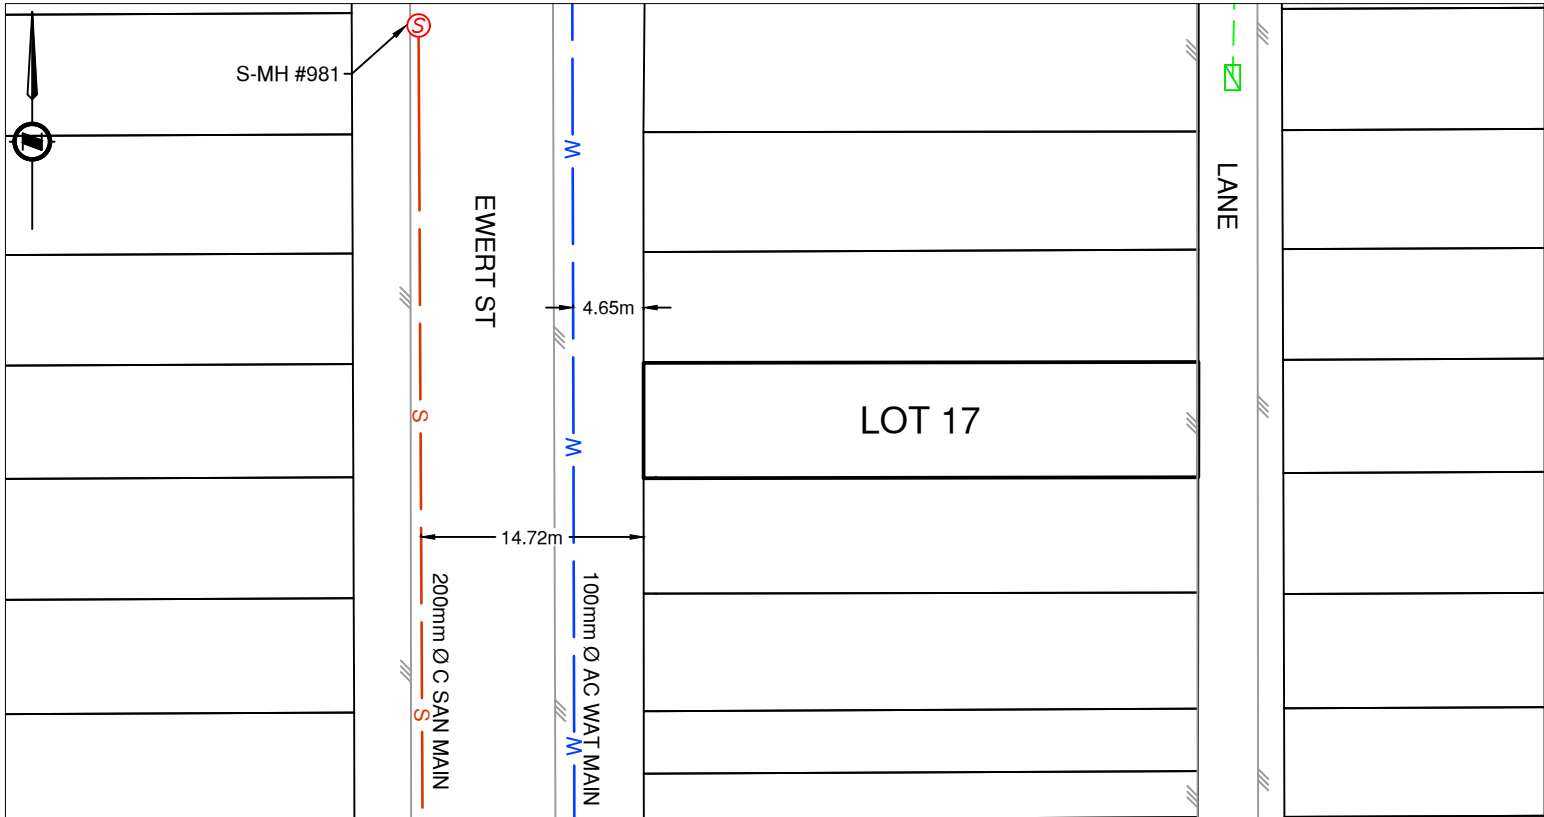

WATER SERVICE AND CURB STOP (CS)	UNDERGROUND GAS LINE
WATER HYDRANT LEAD, VALVE, HYDRANT	WATER MAIN
SANITARY SERVICE AND CLEAN OUT (CO)	SANITARY MAIN
STORM SERVICE	STORM MAIN
ROAD EDGE	ENCUMBRANCE