

**City of Prince George
HISTORY SHEET**

007 897 102

007 897 014

SHEET NUMBER **Nº 2278**

Roll Number **007 897 062**

Legal: LOT'S 23-29-A BLOCK 36 D.L. 957 PLAN 752

Address: 595 IRWIN STREET

Sanitary Connection: # 2759 SIZE 100mm MATERIAL AC INV. CONNECTED

Water Connection # 1067 SIZE 19mm MATERIAL METER CONNECTED

Storm Connection: # SIZE MATERIAL INV. CONNECTED

Cash Receipt No's: WATER SANITARY STORM

CURB FROM PROPERTY LINE 4.871m PAVEMENT WIDTH

B.C. HYDRO OVERHEAD UNDERGROUND CONNECTION



B.C. TELEPHONE OVERHEAD UNDERGROUND CONNECTION

INLAND GAS

Information Sheets:

Comments:

SITE PLAN N.T.S.

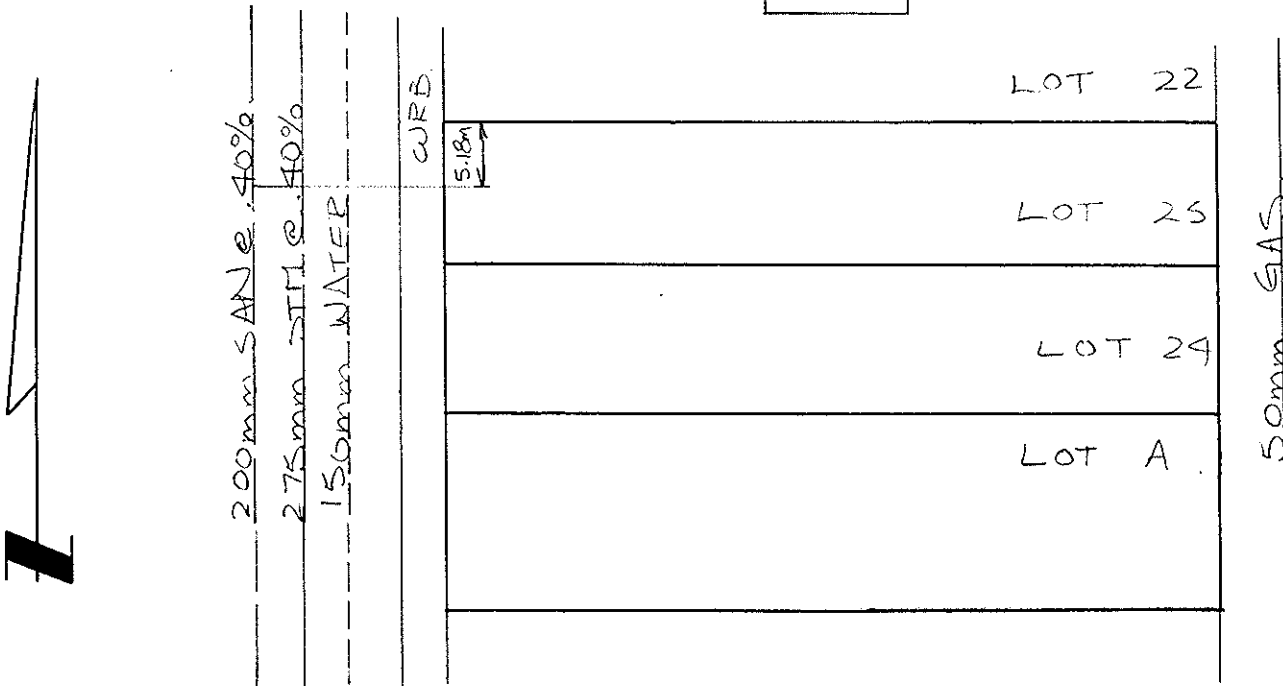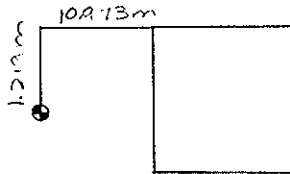

007897 014

REPORT TO RECORDS

WATER SERVICE INFORMATION

Lot No. _____ Block _____ D.L. _____


Address 590 Irwin.

Size of Connection 1/2" 3/4" Other _____

Type of Connection Copper Iron

Thaw Wire Yes No

LOCATION SKETCH

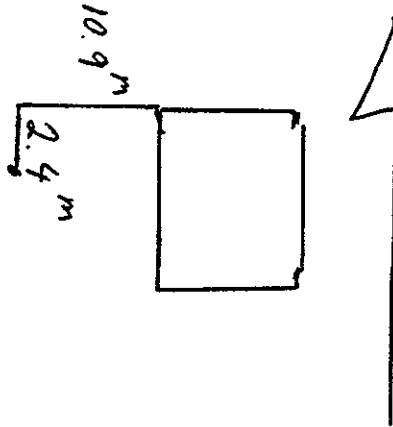

Field Location By R.C. Date 6/8/92

Checked by: _____