

**City of Prince George  
HISTORY SHEET**

007897 111

SHEET NUMBER **N<sup>o</sup> 2272**

Roll Number **007897 120**

**Legal:** LOT'S **7-8** BLOCK **36** D.L. **937** PLAN **752**

**Address:** **539 HARPER STREET**

**Sanitary Connection:** # **3019** SIZE MATERIAL INV. CONNECTED

**Water Connection** # **1780** SIZE **13mm** MATERIAL METER CONNECTED

**Storm Connection:** # SIZE MATERIAL INV. CONNECTED

**Cash Receipt No's:** WATER SANITARY **498** STORM

CURB FROM PROPERTY LINE **4.877m** PAVEMENT WIDTH

B.C. HYDRO **OVERHEAD** UNDERGROUND CONNECTION

B.C. TELEPHONE **OVERHEAD** UNDERGROUND CONNECTION


INLAND GAS

**Information Sheets:**

**Comments:**

The information contained herein is for internal use only. Not to be relied upon unless confirmed by site inspection and/or investigation.

SITE PLAN N.T.S.

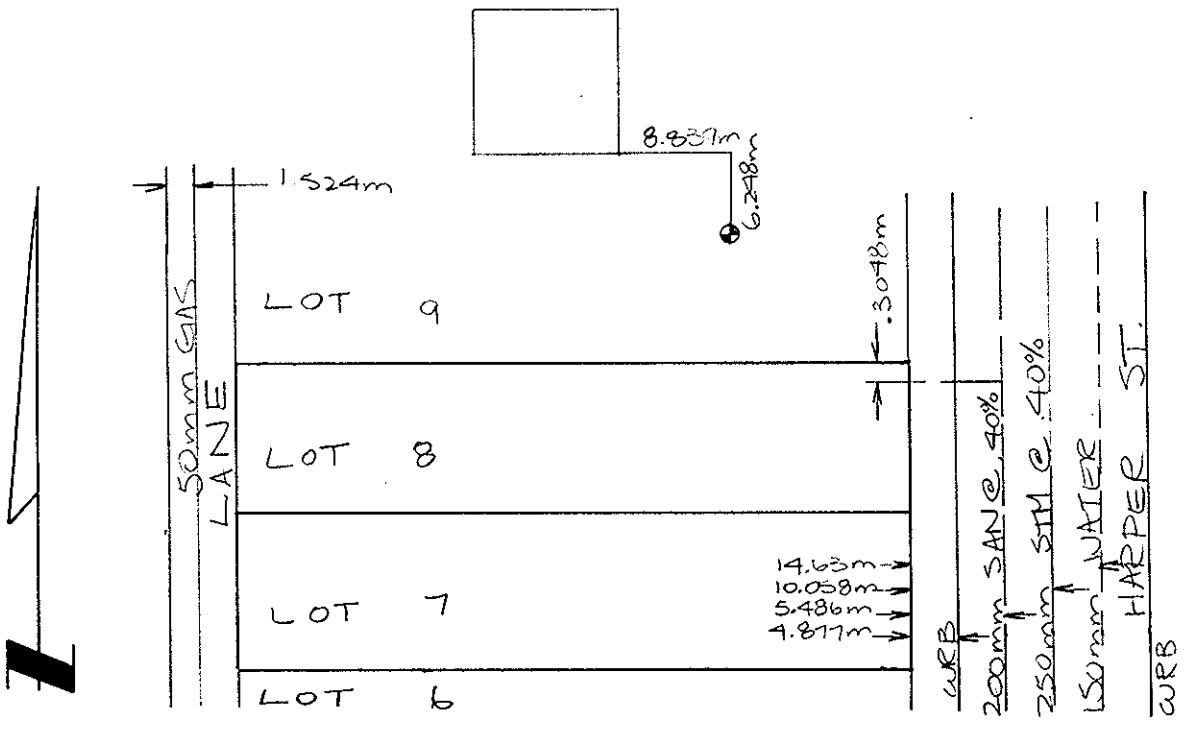

# REPORT TO RECORDS

## WATER SERVICE INFORMATION

Lot No. \_\_\_\_\_ Block \_\_\_\_\_ D.L. \_\_\_\_\_


Address 539 Harper.

Size of Connection  1/2"  3/4"  Other \_\_\_\_\_

Type of Connection  Copper  Iron

Thaw Wire  Yes  No

### LOCATION SKETCH

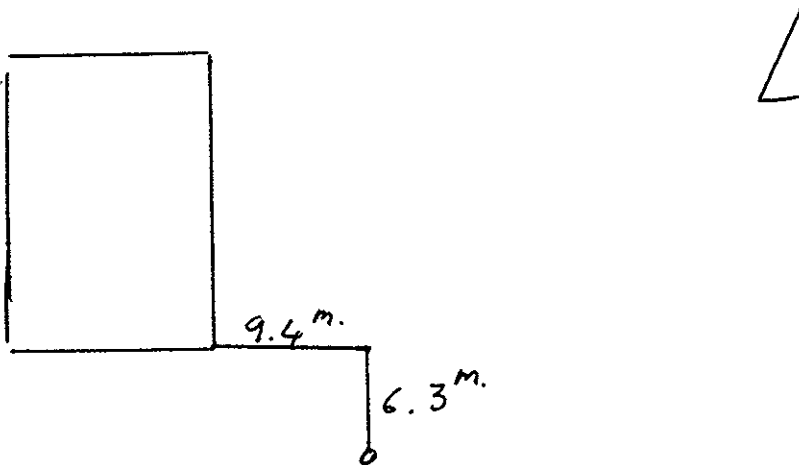

Field Location By G.C. Date 9/6/92.

Checked by: \_\_\_\_\_