

**City of Prince George
HISTORY SHEET**

007892 111

SHEET NUMBER **No 2272**

Roll Number **007892 120**

Legal: LOT'S **7-3** BLOCK **36** D.L. **937** PLAN **752**

Address: **539 HARPER STREET**

Sanitary Connection: # **3019** SIZE MATERIAL INV. **CONNECTED**

Water Connection # **1780** SIZE **13mm** MATERIAL METER **CONNECTED**

Storm Connection: # SIZE MATERIAL INV. **CONNECTED**

Cash Receipt No's: WATER SANITARY **498** STORM

CURB FROM PROPERTY LINE **4.877m** PAVEMENT WIDTH

B.C. HYDRO **OVERHEAD** UNDERGROUND CONNECTION

B.C. TELEPHONE **OVERHEAD** UNDERGROUND CONNECTION


INLAND GAS

Information Sheets:

Comments:

The information contained herein is for internal use only. Not to be relied upon unless confirmed by site inspection and/or investigation.

SITE PLAN N.T.S.

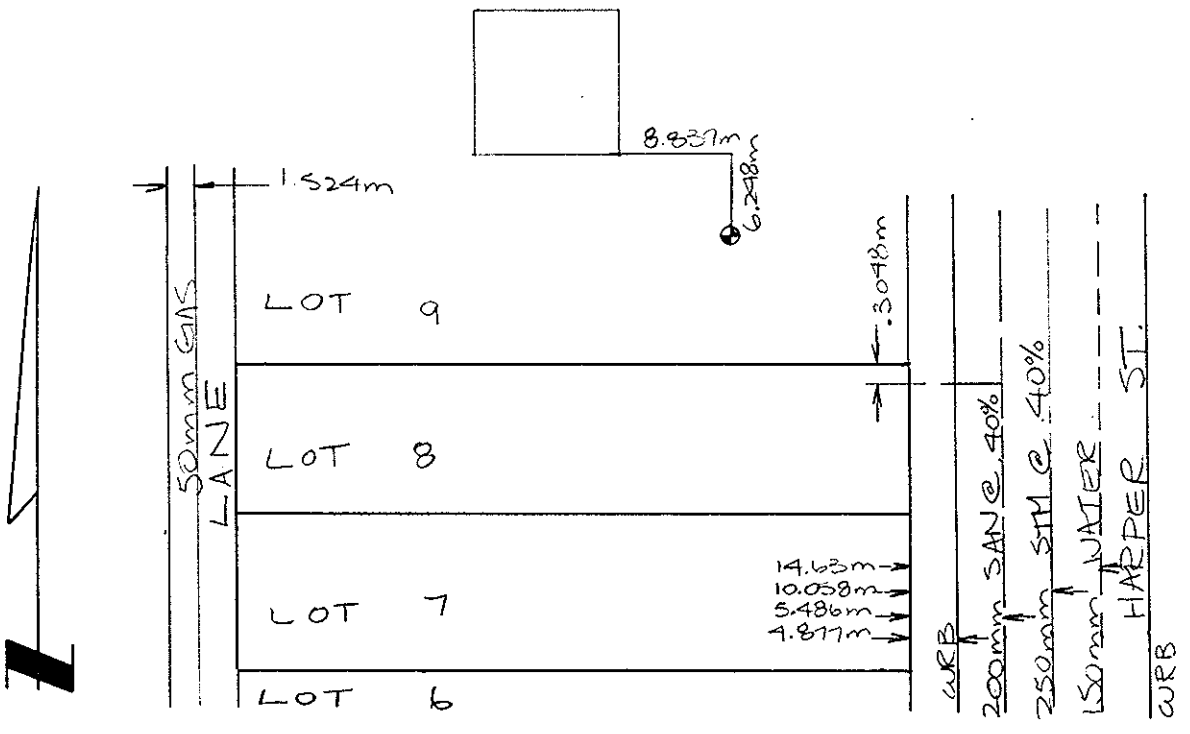

REPORT TO RECORDS

WATER SERVICE INFORMATION

Lot No. _____ Block _____ D.L. _____


Address 539 Harper.

Size of Connection 1/2" 3/4" Other _____

Type of Connection Copper Iron

Thaw Wire Yes No

LOCATION SKETCH

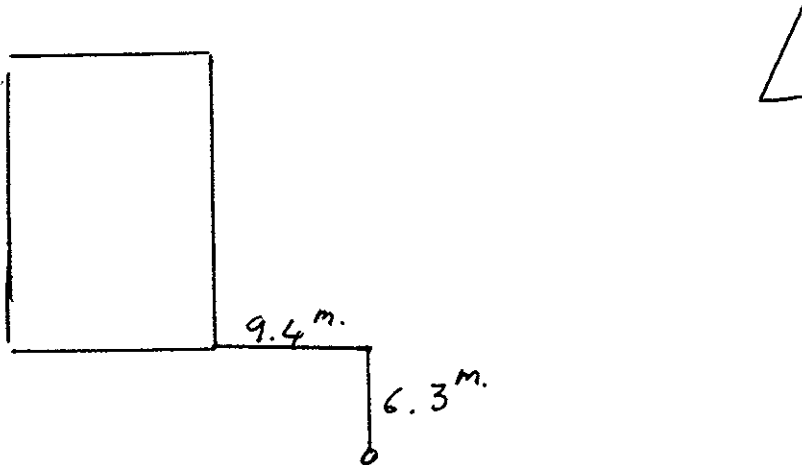

Field Location By G.C. Date 9/6/92.

Checked by: _____