



City of Prince George
History Sheet

PID:	007899181
MU:	102170
WO:	100799/100800

Civic Address: 695 Carney St

Legal Description: Lot: B ASSG (55517M) Block: 30 District Lot: 937 Plan: 752


Service Type	Diameter (mm)	Material	Invert Elev at main (m)	Invert Elev at property line (m)	Invert Elev at service end (m)	Distance into property (m)	Installation Date
Sanitary	100mm	PVC	586.82	586.95	-	-	August 2019
Water	20mm	Copper	587.74	587.07	-	-	August 2019
Storm	N/A	N/A	-	-	-	-	

Service Connection Location				Sanitary (m)	Storm (m)
Distance from downstream San MH	2++8	towards upstream San MH	2664	10.55	
Distance from downstream Stm MH	-	towards upstream Stm MH	-		

Power	Size	Communications	Size	Cable	Size	Gas	Size
BC Hydro	-	Telus	-	Shaw	-	FortisBC	-
Overhead Service		Overhead Service		Overhead Service			

Installed by:	City of Prince George forces	Survey Date:	-
Comments:			

NOT TO SCALE The information contained herein is for internal use only.
Not to be relied on unless confirmed by site inspection and/or investigation.

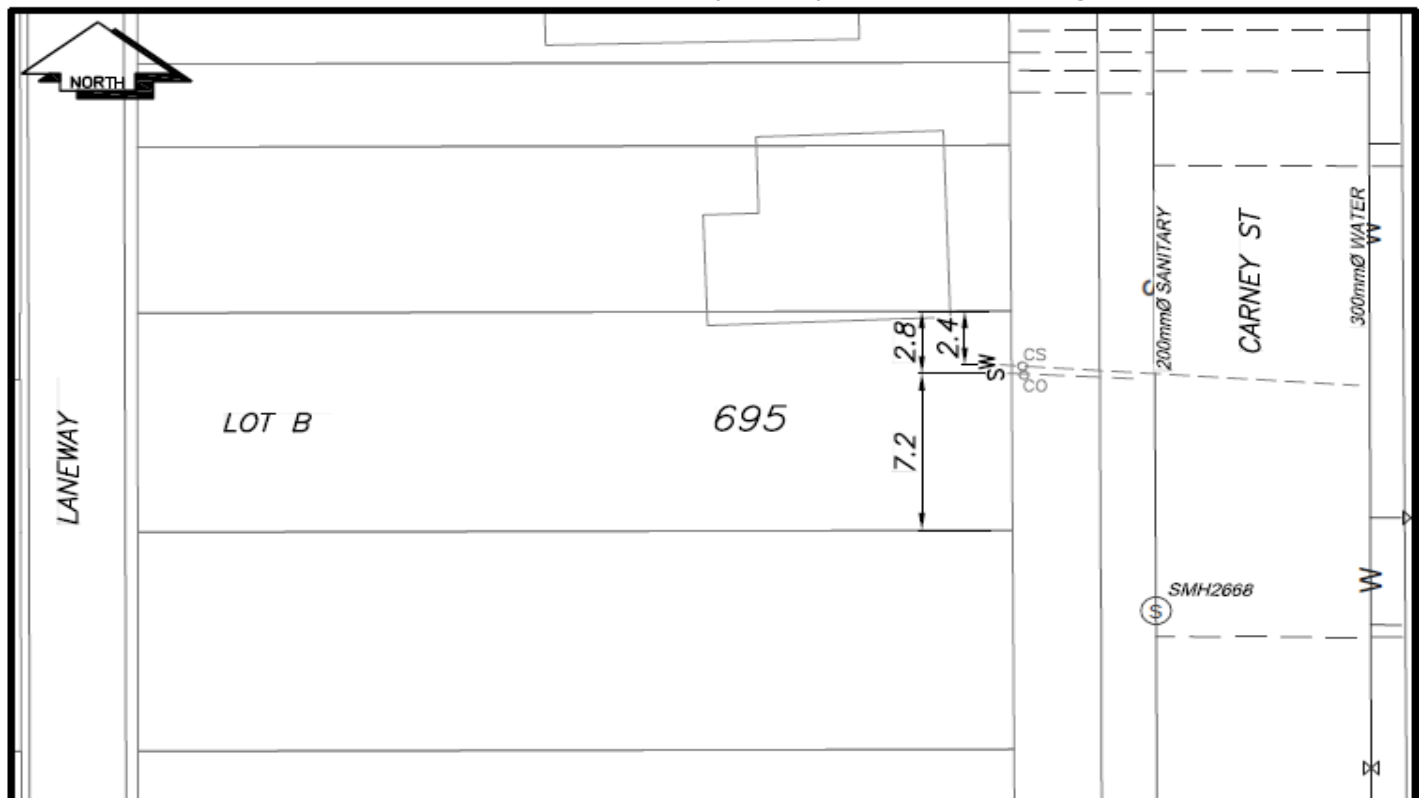

LEGEND:			
CS	CURB STOP	— W —	WATER SERVICE
CO	CLEAN OUT	- - - S - - -	SANITARY SERVICE
⊗	WATER VALVE	— G —	GAS
		— X —	FIRE HYDRANT
		— O —	STORM SERVICE
		- - - - -	ENCUMBRANCE

NOT TO SCALE