

**City of Prince George
HISTORY SHEET**

309908393

SHEET NUMBER

Roll Number 009908431

Legal: LOT'S 21-22 BLOCK 51 D.L. 937 PLAN 752

Address: 474 LYON ST.

Sanitary Connection: # 3788 SIZE 100 mm MATERIAL A.C INV. 598.382 CONNECTED

Water Connection # 3177 SIZE 20 mm MATERIAL C.U. METER CONNECTED

Storm Connection: # SIZE MATERIAL INV. CONNECTED

Cash Receipt No's: WATER SANITARY STORM

CURB FROM PROPERTY LINE 4.877 m PAVEMENT WIDTH 10.363 m


B.C. HYDRO O/H UNDERGROUND CONNECTION

B.C. TELEPHONE O/H UNDERGROUND CONNECTION


INLAND GAS 1.524 m FROM R. IN LANE.

Information Sheets:

Comments: WITH THAW WIRE.

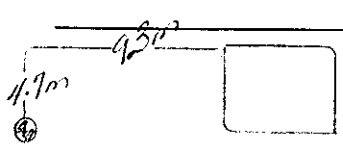

SITE PLAN N.T.S.

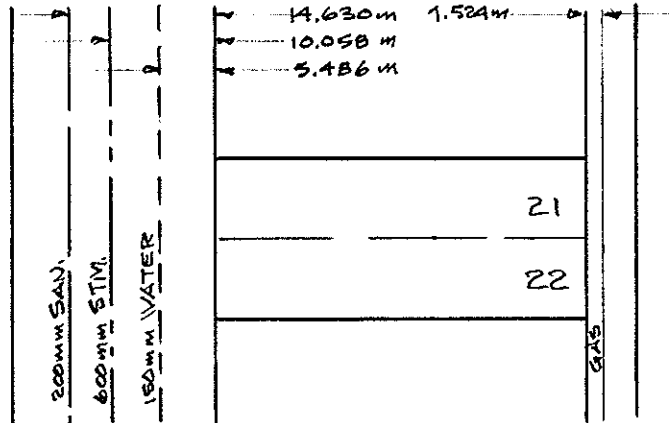

LYON ST.

