

**City of Prince George  
HISTORY SHEET**

009908  
009908644

SHEET NUMBER \_\_\_\_\_ Roll Number \_\_\_\_\_

Legal: LOT'S 14-16 BLOCK 51 D.L. 937 PLAN 7.2

Address: 110 LYON ST.

Sanitary Connection: # \_\_\_\_\_ SIZE 100mm MATERIAL A.C. INV. 597.855 CONNECTED

Water Connection # \_\_\_\_\_ SIZE 20mm MATERIAL CU. METER \_\_\_\_\_ CONNECTED

Storm Connection: # \_\_\_\_\_ SIZE \_\_\_\_\_ MATERIAL \_\_\_\_\_ INV. \_\_\_\_\_ CONNECTED

Cash Receipt No's: WATER \_\_\_\_\_ SANITARY \_\_\_\_\_ STORM \_\_\_\_\_

CURB FROM PROPERTY LINE 4.877 m PAVEMENT WIDTH 10.363 m

B.C. HYDRO O/H UNDERGROUND CONNECTION \_\_\_\_\_

B.C. TELEPHONE O/H UNDERGROUND CONNECTION \_\_\_\_\_

INLAND GAS 1.524 m FROM R IN LANE.

Information Sheets: \_\_\_\_\_

Comments: \_\_\_\_\_

Comments: \_\_\_\_\_


Comments: \_\_\_\_\_

Comments: \_\_\_\_\_

Comments: \_\_\_\_\_

Comments: \_\_\_\_\_

SITE PLAN N.T.S.

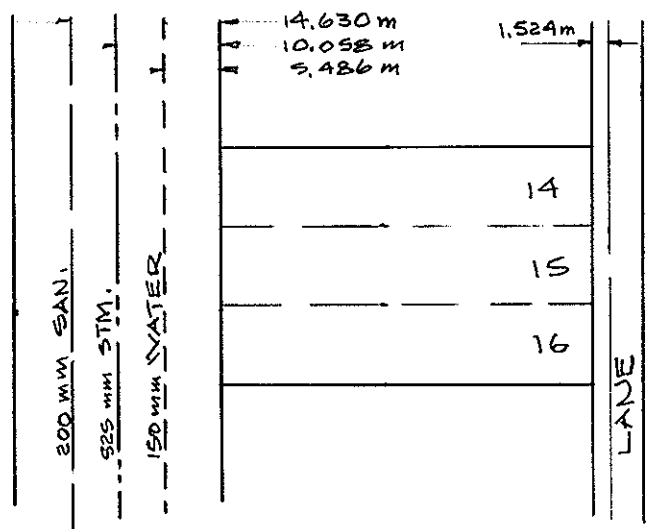

LYON ST.

