

**City of Prince George
HISTORY SHEET**

309910 269

SHEET NUMBER

Roll Number

009911009

Legal: LOT'S 16-17 BLOCK 49 D.L. 937 PLAN 752

Address: 436 N. NICHOLSON ST.

Sanitary Connection: # 3233 SIZE 100mm MATERIAL A.C INV. 602,103 CONNECTED ✓

Water Connection # 3286 SIZE 20mm MATERIAL CU, METER CONNECTED ✓

Storm Connection: # SIZE MATERIAL INV. CONNECTED

Cash Receipt No's: WATER SANITARY STORM

CURB FROM PROPERTY LINE 4.877m PAVEMENT WIDTH 10.363m


B.C. HYDRO O/H UNDERGROUND CONNECTION

B.C. TELEPHONE O/H UNDERGROUND CONNECTION


INLAND GAS 1.524m FROM R IN LANE.

Information Sheets:

Comments: WITH THAW WIRE.

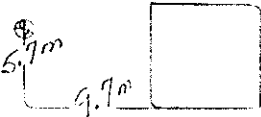

SITE PLAN N.T.S.

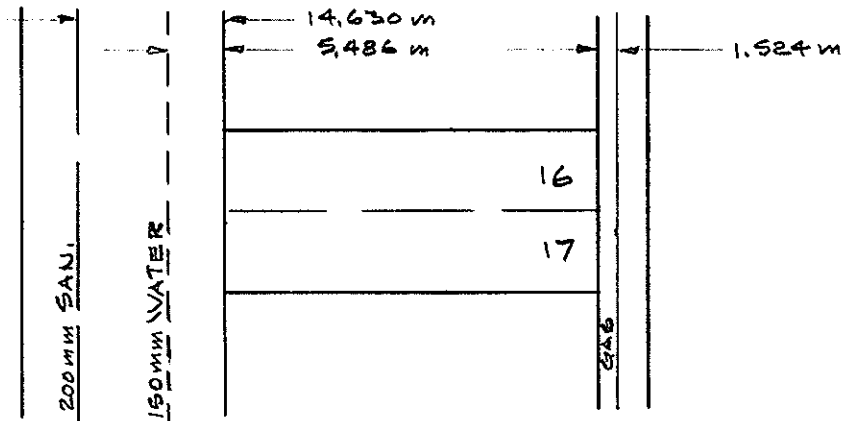

N. NICHOLSON ST.

