

City of Prince George
HISTORY SHEET

309 211 301

SHEET NUMBER

Roll Number

309 211 319

Legal: LOT'S 3-4. BLOCK 119 D.L. 937 PLAN 752

Address: 461 MOFFAT.

Sanitary Connection: # SIZE MATERIAL INV. CONNECTED

Water Connection # SIZE 50mm MATERIAL Cc METER CONNECTED

Storm Connection: # SIZE MATERIAL INV. CONNECTED

Cash Receipt No's: WATER SANITARY STORM

CURB FROM PROPERTY LINE PAVEMENT WIDTH


B.C. HYDRO UNDERGROUND CONNECTION

B.C. TELEPHONE UNDERGROUND CONNECTION

INLAND GAS

Information Sheets:

Comments:

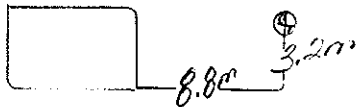

SITE PLAN N.T.S.

