

City of Prince George HISTORY SHEET

550-239

SHEET NUMBER

Roll Number 0099/1343

Legal: LOT'S 1-5 BLOCK 49 D.L. 937 PLAN 752

Address: 185 MOFFAT ST

Sanitary Connection: # 3165 SIZE 100 mm MATERIAL INV. CONNECTED

Water Connection # 3188 SIZE 20 mm MATERIAL Cu METER CONNECTED

Storm Connection: # SIZE MATERIAL INV. CONNECTED

Cash Receipt No's: WATER SANITARY STORM

CURB FROM PROPERTY LINE 4.877 m PAVEMENT WIDTH 10.363 m


B.C. HYDRO O/H UNDERGROUND CONNECTION

B.C. TELEPHONE O/H UNDERGROUND CONNECTION

INLAND GAS AS SHOWN

Information Sheets:

Comments:

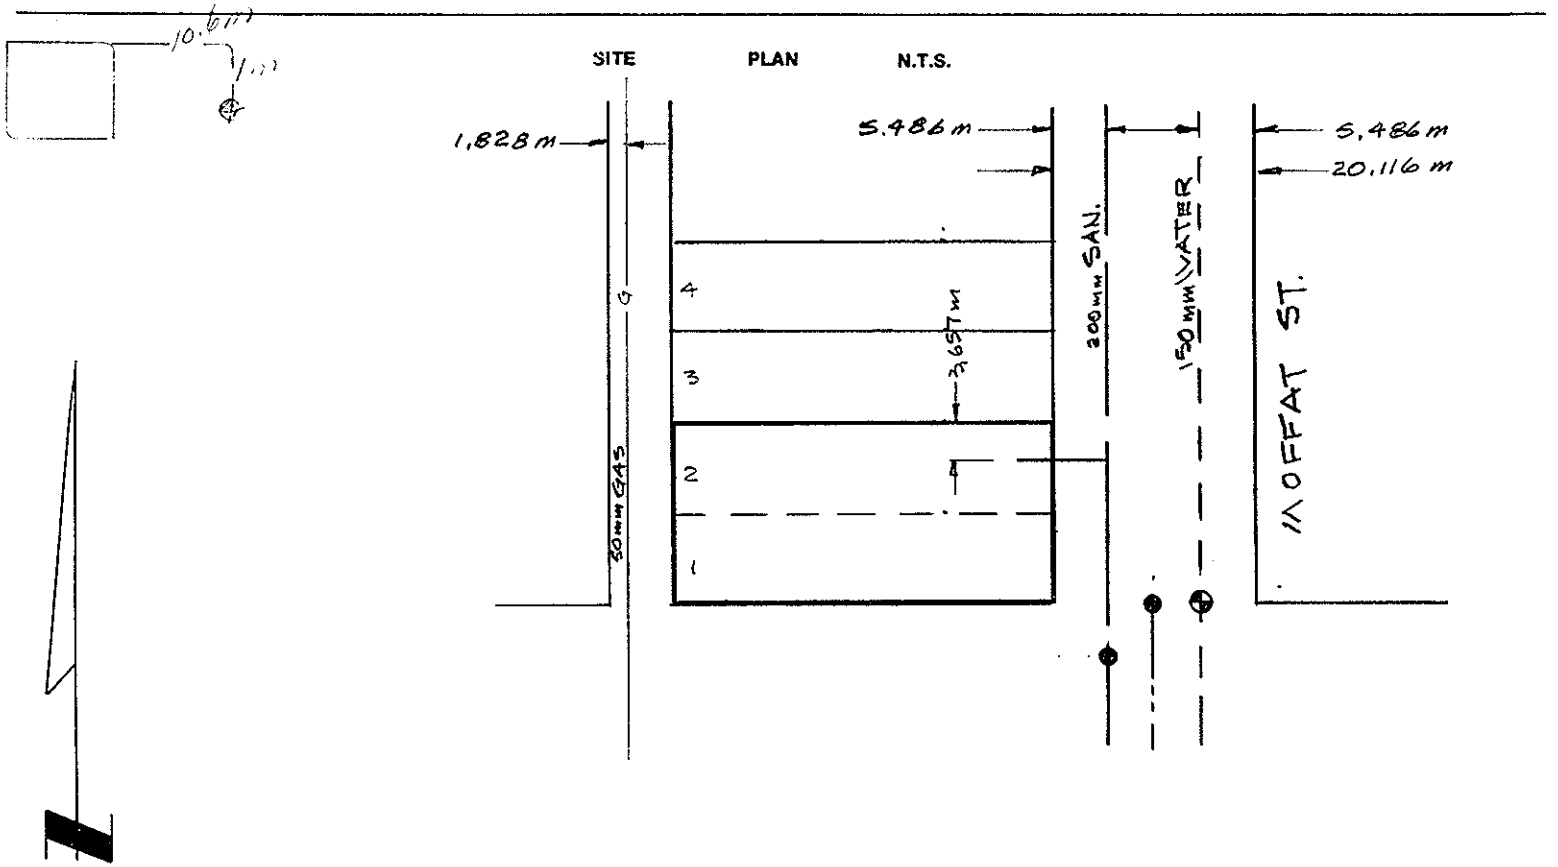

REPORT TO RECORDS

SEWER SERVICE INFORMATION

Lot No. _____ Block _____ D.L. _____


Address 485 MOFFAT.

Size of Connection 100mm 150mm 200mm Other _____

Type of Connection Transite PVC Other _____

Type of Cap Transite Cast Iron

LOCATION SKETCH

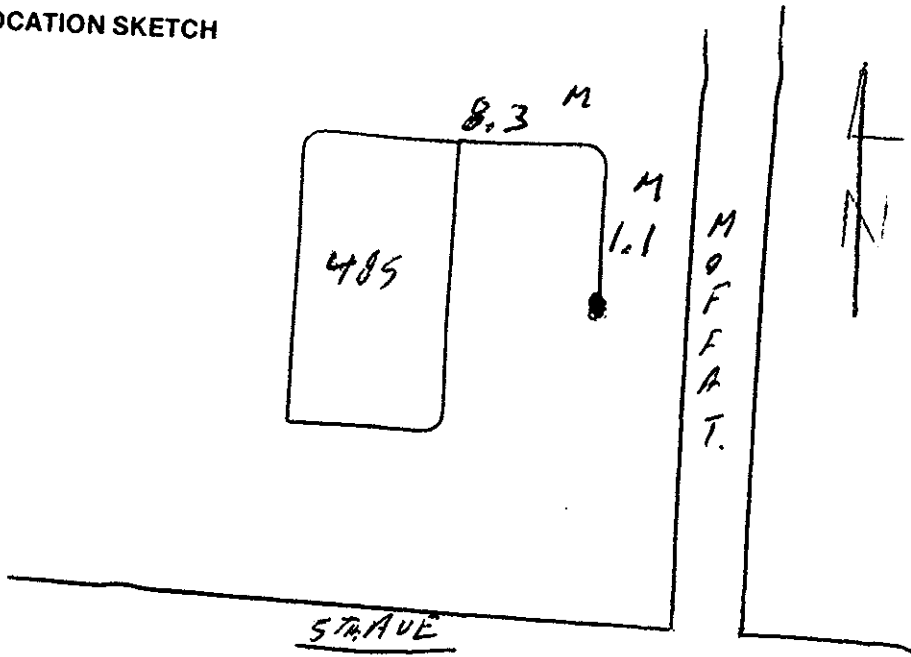

Field Location By ALVIN H. COY Date OCT 24/95

Checked by Foreman - Sewer Division _____