

City of Prince George  
HISTORY SHEET

SHEET NUMBER

Roll Number

Legal: LOT'S

BLOCK

D.L.

PLAN

Address:

Sanitary Connection: #

SIZE

MATERIAL

INV.

CONNECTED

Water Connection #

SIZE

MATERIAL

METER

CONNECTED

Storm Connection: #

SIZE

MATERIAL

INV.

CONNECTED

Cash Receipt No's:

WATER

SANITARY

STORM

CURB FROM PROPERTY LINE

PAVEMENT WIDTH

B.C. HYDRO

UNDERGROUND CONNECTION


B.C. TELEPHONE

UNDERGROUND CONNECTION

INLAND GAS

Information Sheets:

Comments:

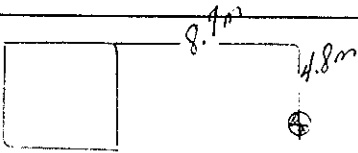

SITE

PLAN

N.T.S.