

City of Prince George  
HISTORY SHEET

009911483

SHEET NUMBER

Roll Number

009911505

Legal: LOT'S 1-2 BLOCK 17 D.L. 937 PLAN 152

Address: 487 OGDON ST.

Sanitary Connection: # SIZE MATERIAL INV. CONNECTED

Water Connection # SIZE 50mm MATERIAL Cu METER CONNECTED

Storm Connection: # SIZE MATERIAL INV. CONNECTED

Cash Receipt No's: WATER SANITARY STORM

CURB FROM PROPERTY LINE PAVEMENT WIDTH


B.C. HYDRO UNDERGROUND CONNECTION

B.C. TELEPHONE UNDERGROUND CONNECTION

INLAND GAS

Information Sheets:

Comments:

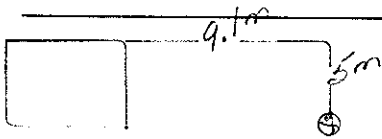

SITE

PLAN

N.T.S.

