

**City of Prince George
HISTORY SHEET**

SHEET NUMBER **2222** Roll Number **009916655**

Legal: LOT'S **36** BLOCK D.L. **633** PLAN **25111**

Address: **1844 BACHINSKI CRES.**

Sanitary Connection: # SIZE **100 mm ϕ** MATERIAL **PVC** INV. **674.78 m** CONNECTED

Water Connection # SIZE **20 mm ϕ** MATERIAL **Cu** METER CONNECTED

Storm Connection: # SIZE **100 mm ϕ** MATERIAL **PVC** INV. **674.88 m** CONNECTED

Cash Receipt No's: WATER SANITARY STORM

CURB FROM PROPERTY LINE **5 m** PAVEMENT WIDTH **10 m**

B.C. HYDRO **U/G CONNECTION @ MID LOT** UNDERGROUND CONNECTION

B.C. TELEPHONE **U/G CONNECTION @ MID LOT.** UNDERGROUND CONNECTION


INLAND GAS

THE INFORMATION CONTAINED HEREIN IS FOR INTERNAL USE ONLY. NOT TO BE RELIED UPON UNLESS CONFIRMED BY SITE INSPECTION AND/OR INVESTIGATION.

Information Sheets:

Comments: **GEODETIC BENCH MARK EL. 682.067 m**
BLACKBURN ELEMENTARY SCHOOL GYM
TABLET ON CONCRETE WALL - NORTH SIDE

SITE PLAN N.T.S.

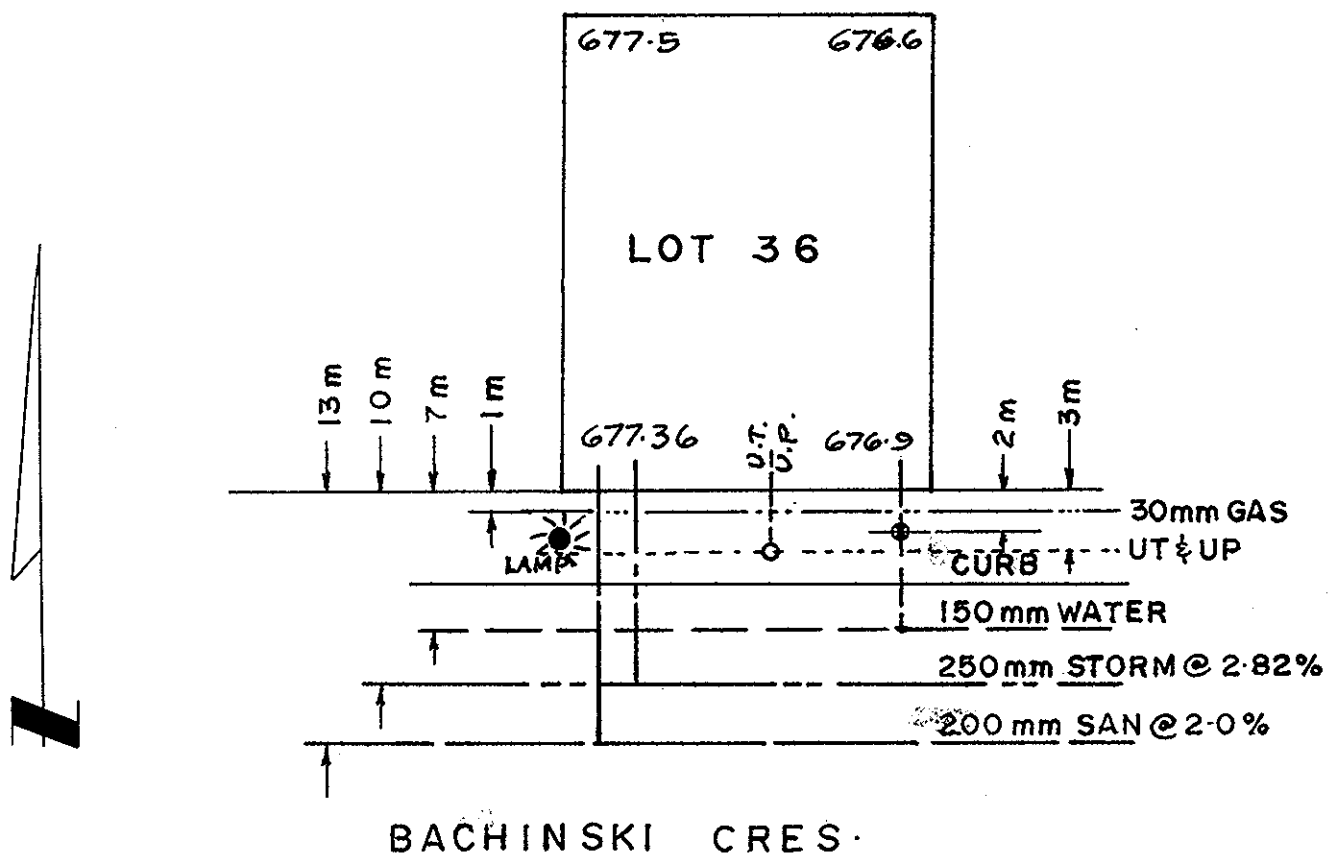

BACHINSKI CRES.