
City of Prince George

HISTORY SHEET

SHEET NUMBER				PID# 007 923 465		
Legal: Lors	33	BLOCK		D.L. 8175	PLAN 16074	
Address:	269	5 WEST	T \\/00 \	ORIVE.		
Sanitary Connection	: # 5937	SIZE (OO	mm MATERIAL	A.C. INV.	CONNECTED	
Water Connection:	# 5937	SIZE ZO	mm MATERIAL	CU METER	CONNECTED	
Storm Connection:	#	SIZE	mm MATERIAL	INV.	CONNECTED	
Cash Receipt No's:	WATER		SANITARY		STORM	
CURB FROM PROPERTY LINE	4,877m@	FAIRVEIW;		PAVE	MENT WIDTH 10,363 FAIRVIE	
B.C. HYDRO U/CA		,	UNDERGROU	JND CONNECTION		
B.C. TELEPHONE 4		,	UNDERGROU	JND CONNECTION		
INLAND GAS 1:524	tm FROM	R. @ LA	ANE			
Information Sheets:						
Comments:						

THE INFORMATION CONTAINED HEREIN IS FOR INTERNAL USE ONLY. NOT TO BE RELIED UPON UNLESS CONFIRMED BY SITE INSPECTION AND/OR INVESTIGATION

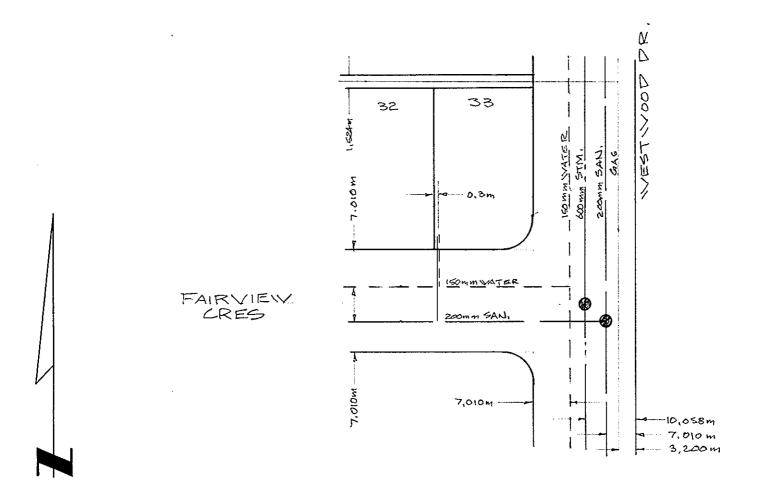

SANITARY & STORM INVERT CALCULATIONS	SANITARY	STORM
Distance from M.H to connection point is		
Calculated invert of main to conn. pt. is		
Main Size at connection point isins.		
Conn. invert at half diameter (Crown) of main is		
Add to (4) allowance of 0.2 for 1/8 bend. Adjusted invert now		
6. Dist. from main to P/L equals		
7. Item (5) plus (6) equals Calculated Elev. of conn. inv. at P/L equals		
13. Elev. of ref. hub top	587,223	
14. Elev. of invert at P/Line		
15. Difference or cut below at property line		***************************************
16. Survey Date		
17. Cut at P/Line in feet and inches		
O 111		
Sanitary History:		
	***************************************	78

	· · · · · · · · · · · · · · · · · · ·	
	· · · · · · · · · · · · · · · · · · ·	
Water History:		

Storm History:		
	110	
,		