



City of Prince George
History Sheet

PID:	007937458
	007937474
SD/MU:	
WO:	

Civic Address: 456. 462 Freeman St

Legal Description: Lot: 20, 21 Block: 58 District Lot: 937 Plan: 752


Service Type	Diameter (mm)	Material	Invert Elev at main (m)	Invert Elev at property line (m)	Invert Depth at service end (m)	Distance into property (m)	Installation Date
Sanitary (S1)	100mm	AC	-	-	2.46	-	December 1960
Water (W1)	20mm	Copper	-	-	-	-	December 1960
Sanitary (S2)	100mm	AC	-	-	2.10	-	December 1960
Water (W2)	20mm	Copper	-	-	-	-	December 1960
Storm	N/A	N/A	-	-	-	-	

Service Connection Location				Sanitary (m)	Storm (m)
Distance from downstream San MH	1643	towards upstream San MH	976	-	
Distance from downstream San MH	1643	towards upstream San MH	976		

Power	Size	Communications	Size	Cable	Size	Gas	Size
BC Hydro	-	Telus	-	Shaw	-	FortisBC	-
Overhead Service		Overhead Service		Overhead Service			

Installed by:	Survey Date:	-
Comments:		

NOT TO SCALE The information contained herein is for internal use only.
 Not to be relied on unless confirmed by site inspection and/or investigation.

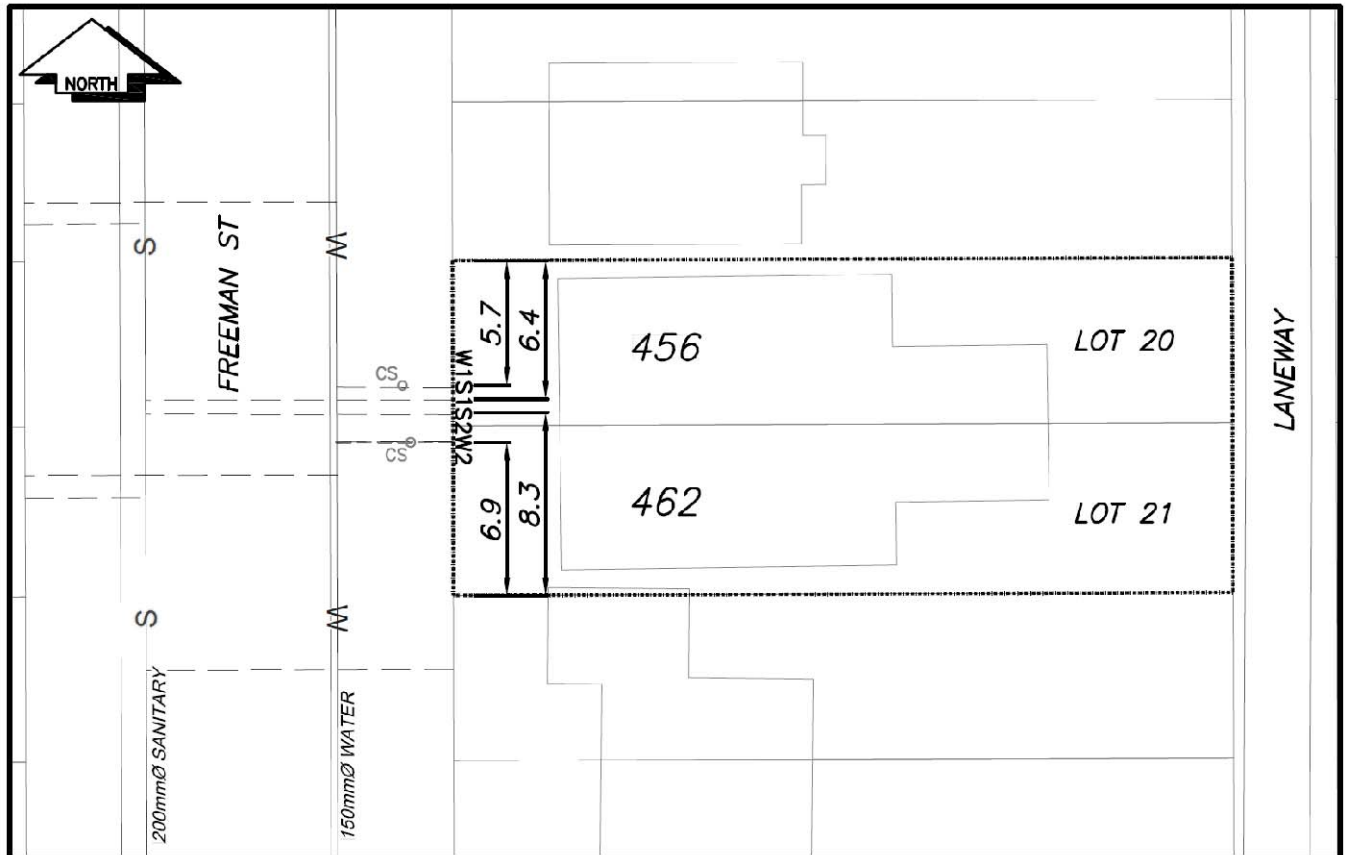

LEGEND:		
CS	CURB STOP	NOT TO SCALE
CO	CLEAN OUT	— SANITARY SERVICE
⊗	WATER VALVE	— GAS
		— FIRE HYDRANT
		— ENCUMBERANCE
		— STORM SERVICE