



City of Prince George  
**History Sheet**

PID:	007942389
	007942371
	007942362
	007942346
SD/MU:	
WO:	

Civic Address: 425 Brunswick St

Legal Description: Lot: 7 - 10 Block: 153 District Lot: 343 Plan: 1268


Service Type	Diameter (mm)	Material	Invert Elev at main (m)	Invert Elev at property line (m)	Invert Elev at service end (m)	Distance into property (m)	Installation Date
Sanitary	100mm	AC	-	-	-	-	December 1956
Water	40mm	Copper	-	-	-	-	December 1956
Storm (D1)	100mm	AC	-	-	-	-	December 1971
Storm (D2)	250mm	PVC	-	-	-	-	January 2010

Service Connection Location				Sanitary (m)	Storm (m)
Distance from downstream San MH	2004	towards upstream San MH	2010	84.00	
Distance from downstream Stm MH	1292	towards upstream Stm MH	1296		11.39
250mm storm service connected to Stm MH4107				-	

Power	Size	Communications	Size	Cable	Size	Gas	Size
BC Hydro	-	Telus	-	Shaw	-	FortisBC	-
Overhead Service		Overhead Service		Overhead Service			

Installed by:	City of Prince George forces	Survey Date:	-
Comments:			

**NOT TO SCALE** The information contained herein is for internal use only.  
Not to be relied on unless confirmed by site inspection and/or investigation.

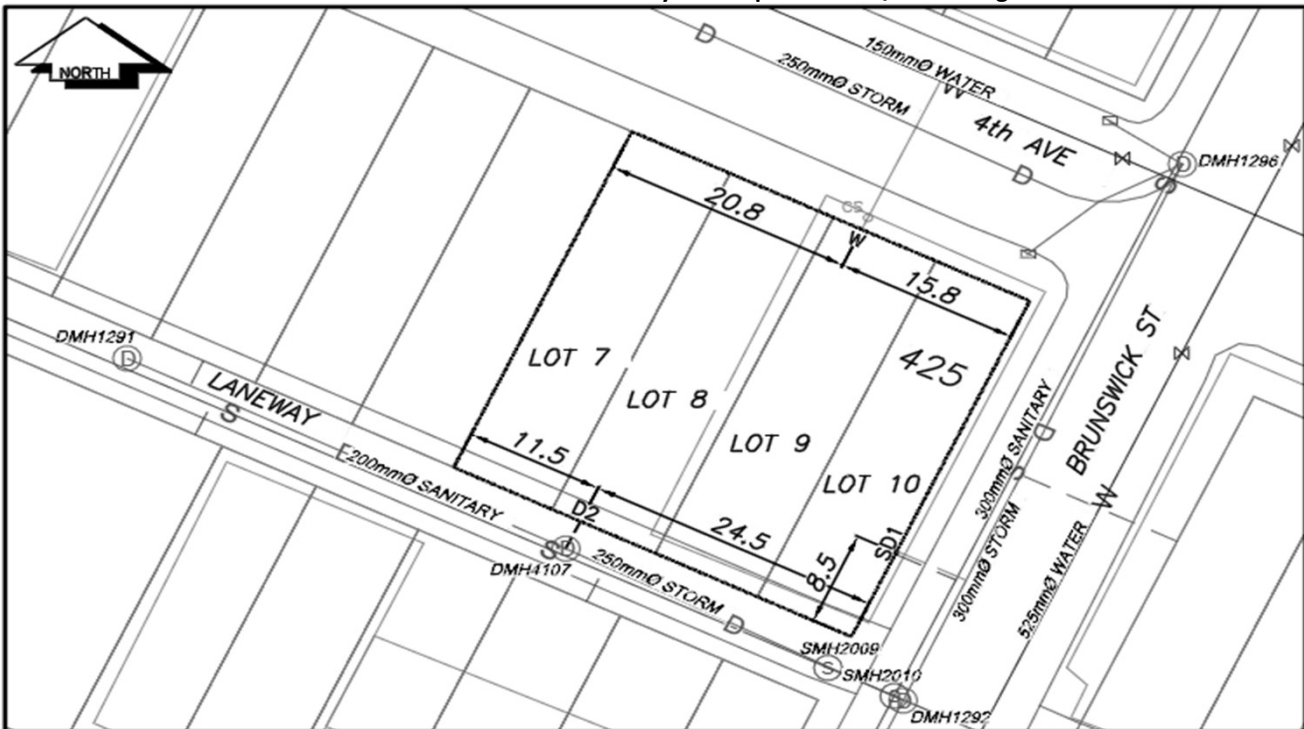

LEGEND:			
CS	CURB STOP	---W	WATER SERVICE
CO	CLEAN OUT	---S	SANITARY SERVICE
⊗	WATER VALVE	⊗	FIRE HYDRANT
		---	STORM SERVICE
		-G-	GAS
		---	ENCUMBRANCE

**NOT TO SCALE**