



City of Prince George  
**History Sheet**

PID:	007948441
	007948441
MU:	102126
WO:	5014514

Civic Address: 490 Quebec St

Legal Description: Lot: 19, 20 Block: 151 District Lot: 343 Plan: 1268


Service Type	Diameter (mm)	Material	Invert Elev at main (m)	Invert Elev at property line (m)	Invert Elev at service end (m)	Distance into property (m)	Installation Date
Sanitary	100mm	AC	-	-	-	-	December 1983
Water	50mm	Copper	-	-	-	-	July 2019
Storm	N/A	N/A	-	-	-	-	

Service Connection Location				Sanitary (m)	Storm (m)
Distance from downstream San MH	3104	towards upstream San MH	3103	39.56	
Distance from downstream Stm MH	-	towards upstream Stm MH	-		

Power	Size	Communications	Size	Cable	Size	Gas	Size
BC Hydro	-	Telus	-	Shaw	-	FortisBC	-
Overhead Service		Overhead Service		Overhead Service			

Installed by:	City of Prince George forces	Survey Date:	-
Comments:			

**NOT TO SCALE** The information contained herein is for internal use only.  
Not to be relied on unless confirmed by site inspection and/or investigation.

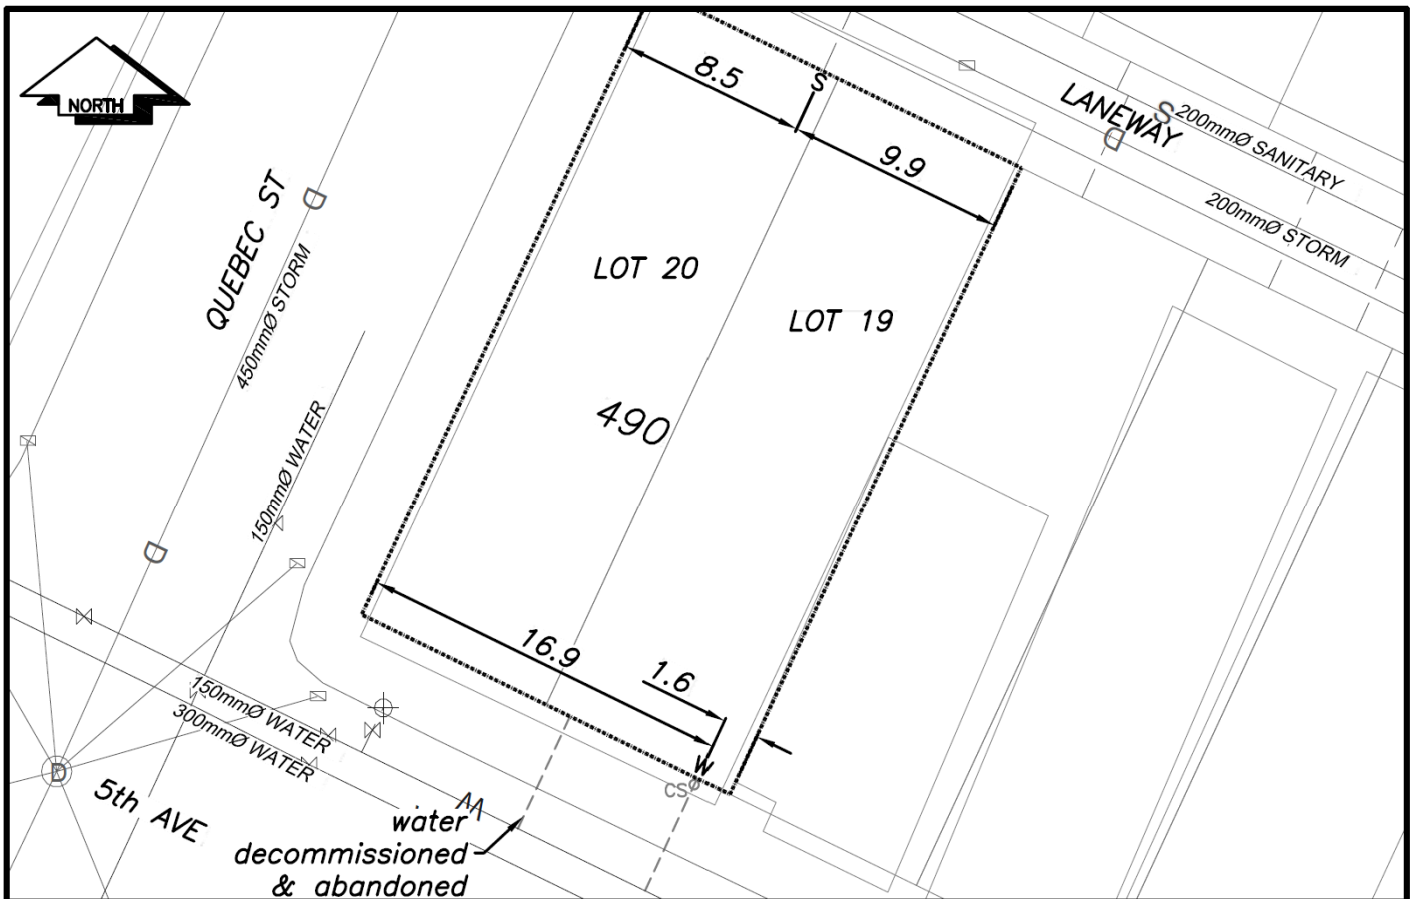

 
**NOT TO SCALE**

CS	CURB STOP	—W—	WATER SERVICE	—S—	SANITARY SERVICE	—G—	GAS
CO	CLEAN OUT	—W—	ENCUMBRANCE	—S—	ENCUMBRANCE		
⊗	WATER VALVE	—W—	ENCUMBRANCE	—S—	ENCUMBRANCE		

LEGEND:

 WATER VALVE

 FIRE HYDRANT

 ENCUMBRANCE

---

NOT TO SCALE