
## City of Prince George

	HISTORY SHEET						307970 <i>099</i>	
SHEET NUMBER					Roll Number /02			
Legal: LOT'S	15-16	BLOCK	62	D.L.	937	PLAN	752	
Address:	322 Ew	ERT 5T						
Sanitary Connection:	# <i>30</i> 1	SIZE 4"	MATERIAL	AC.	INV.		CONNECTED	
Water Connection #	2523	SIZE 3/4	MATERIAL	Cu	METER		CONNECTED	
Storm Connection: #		SIZE	MATERIAL		INV.		CONNECTED	
Cash Receipt No's:	WATER		SANITARY	0766		STORM		
CURB FROM PROPERTY LINE					PAVEMEN	T WIDTH		
B.C. HYDRO		UNDERGROUND CONNECTION						
B.C. TELEPHONE		UNDERGROUND CONNECTION						
INLAND GAS					<b></b>			
Information Sheets:								

## THE INFORMATION CONTAINED HEREIN IS FOR INTERNAL USE ONLY. NOT TO BE RELIED UPON UNLESS CONFIRMED BY SITE INSPECTION AND/OR INVESTIGATION

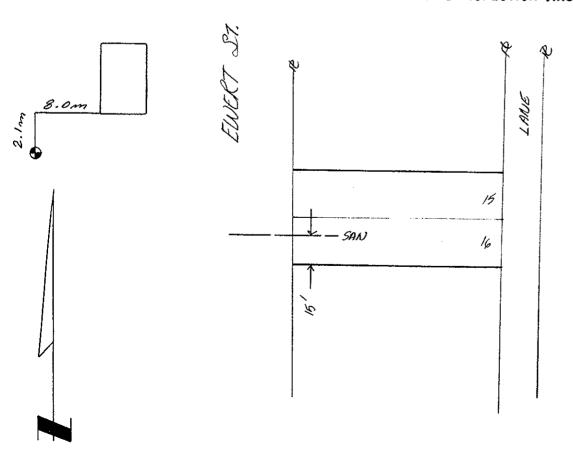

Comments: