

**City of Prince George
HISTORY SHEET**

35-56496 HM

SHEET NUMBER **N^o 1469** Roll Number **3079% 318**

Legal: LOT'S **19, 20** BLOCK **54** D.L. **937** PLAN **752**

Address: **462 JOHNSON STREET**

Sanitary Connection: # **7165** SIZE **4"** MATERIAL **A.C.** INV. **CONNECTED**

Water Connection # **1122** SIZE **1/2"** MATERIAL **COPPER** METER **CONNECTED**

Storm Connection: # SIZE MATERIAL INV. **CONNECTED**

Cash Receipt No's: WATER SANITARY STORM

CURB FROM PROPERTY LINE PAVEMENT WIDTH


B.C. HYDRO UNDERGROUND CONNECTION

B.C. TELEPHONE UNDERGROUND CONNECTION

INLAND GAS

Information Sheets:

Comments:

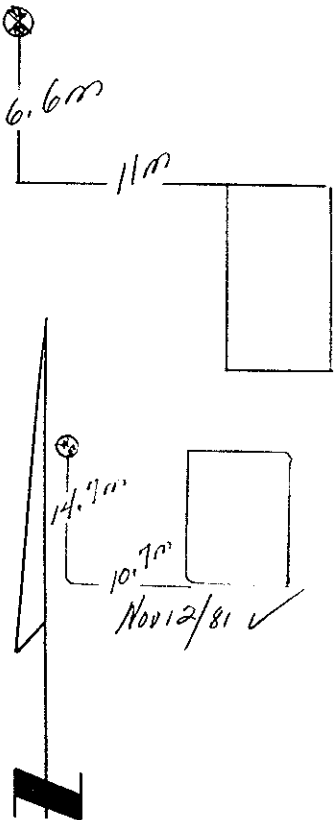

SITE PLAN N.T.S.

