

**City of Prince George
HISTORY SHEET**

009999/134 HM

SHEET NUMBER

Roll Number 009999/193

Legal: LOT'S 17-18 BLOCK SA D.L. 937 PLAN 752

Address: 446 JOHNSON ST.

Sanitary Connection: # 3861 SIZE 100mm MATERIAL A.C. INV. CONNECTED

Water Connection # 1788 SIZE 13mm MATERIAL METER CONNECTED

Storm Connection: # SIZE MATERIAL INV. CONNECTED

Cash Receipt No's: WATER SANITARY 1785 STORM

CURB FROM PROPERTY LINE 4.877m PAVEMENT WIDTH 10.363m


B.C. HYDRO 1/4 IN LANE UNDERGROUND CONNECTION

B.C. TELEPHONE 1/4 IN LANE UNDERGROUND CONNECTION

INLAND GAS IN LANE AS SHOWN

Information Sheets:

Comments: DUAL S 1/4 LOT 18 WITH 462 JOHNSON STR.

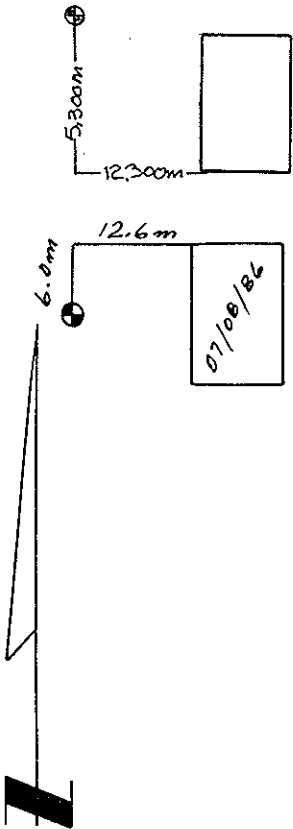

SITE PLAN N.T.S.

