



City of Prince George  
**History Sheet**

PID:	007989903
	007989938
SD/MU:	
WO:	5017901

Civic Address: 1770 5th Ave

Legal Description: Lot: 21, 22 Block: 156 District Lot: 343 Plan: 1268


Service Type	Diameter (mm)	Material	Invert Elev at main (m)	Invert Elev at property line (m)	Invert Depth at service end (m)	Distance into property (m)	Installation Date
Sanitary	100mm	AC	-	578.16	2.38	-	December 1955
Water	13mm	Copper	577.16	577.61	-	-	December 1956
Storm	N/A	N/A	-	-	-	-	

Service Connection Location				Sanitary (m)	Storm (m)
Distance from downstream San MH	1995	towards upstream San MH	2703	94.67	
Distance from downstream Stm MH	-	towards upstream Stm MH	-		

Power	Size	Communications	Size	Cable	Size	Gas	Size
BC Hydro	-	Telus	-	Shaw	-	FortisBC	-
Overhead Service		Overhead Service		Overhead Service			

Installed by:	City of Prince George forces	Survey Date:	-
Maintenance on wa Maintenance on water service completed on April 20, 2020			

**NOT TO SCALE** The information contained herein is for internal use only.  
Not to be relied on unless confirmed by site inspection and/or investigation.

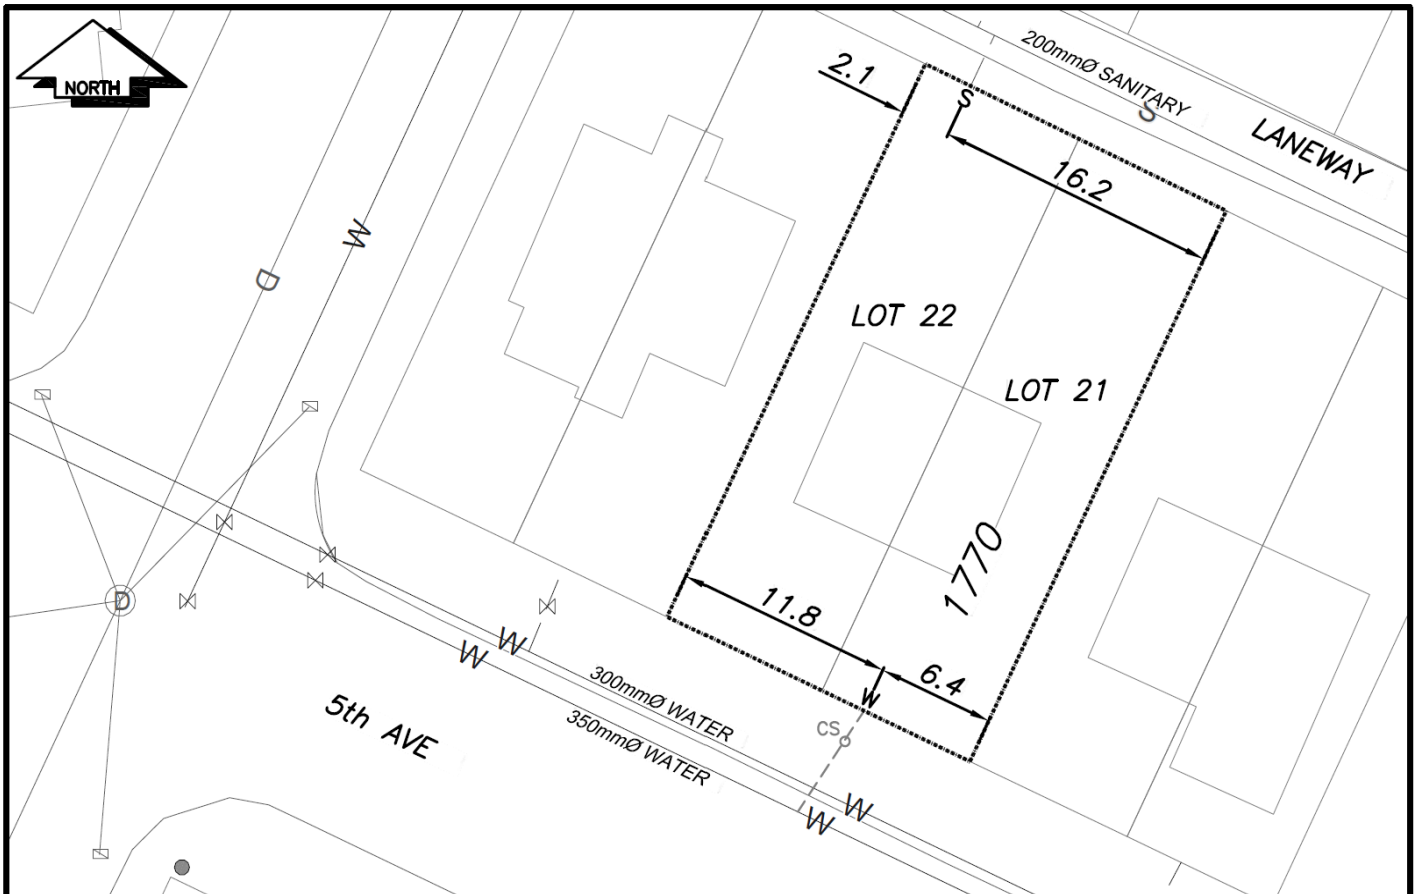

LEGEND:			
CS <sup>o</sup>	CURB STOP	—G—	GAS
CO <sup>o</sup>	CLEAN OUT	—S—	ENCUMBRANCE
⊗	WATER VALVE	—W—	WATER SERVICE
⊗	FIRE HYDRANT	—S—	SANITARY SERVICE
⊗	STORM SERVICE		