

**City of Prince George  
HISTORY SHEET**

009997/108 HM

SHEET NUMBER

Roll Number 009997/422

Legal: LOT'S 24 & A BLOCK 68 D.L. 937 PLAN 752

Address: 386 EAST CENTRAL ST.

Sanitary Connection: # 3038 SIZE 100MM MATERIAL A.C. INV. 596.721 CONNECTED

Water Connection # 3207 SIZE 20MM MATERIAL CU. METER CONNECTED

Storm Connection: # SIZE MATERIAL INV. CONNECTED

Cash Receipt No's: WATER SANITARY STORM

CURB FROM PROPERTY LINE 4.877 PAVEMENT WIDTH 9.144 m


B.C. HYDRO 0/H UNDERGROUND CONNECTION

B.C. TELEPHONE 0/H UNDERGROUND CONNECTION

INLAND GAS 1.524 m FROM R IN LANE.

Information Sheets:

Comments: WITH THIN WIRE.

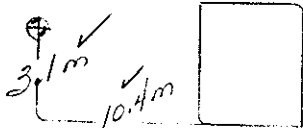

SITE PLAN N.T.S.

