

City of Prince George  
HISTORY SHEET

775  
58014 387

SHEET NUMBER

Roll Number

795

Legal: LOT'S 10-11-12 BLOCK 80 D.L. 937 PLAN 732

Address: 213 Lynd

Sanitary Connection: # 3781 SIZE MATERIAL INV. CONNECTED

Water Connection # 3479 SIZE 20mm MATERIAL Cu. METER CONNECTED

Storm Connection: # SIZE MATERIAL INV. CONNECTED

Cash Receipt No's: WATER SANITARY STORM

CURB FROM PROPERTY LINE PAVEMENT WIDTH


B.C. HYDRO UNDERGROUND CONNECTION

B.C. TELEPHONE UNDERGROUND CONNECTION

INLAND GAS

Information Sheets:

Comments:

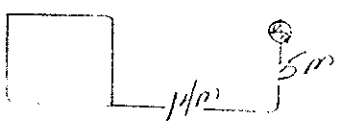

SITE PLAN N.T.S.

