

**City of Prince George
HISTORY SHEET**

10804/117
288

SHEET NUMBER

Roll Number

Legal: LOT'S 21-22 BLOCK 80 D.L. 937 PLAN 752

Address: 274 MOFFAT ST.

Sanitary Connection: # 3181 SIZE 100 mm MATERIAL A.C. INV. 602.820 CONNECTED

Water Connection # 3013 SIZE 20 mm MATERIAL CU. METER CONNECTED

Storm Connection: # SIZE MATERIAL INV. CONNECTED

Cash Receipt No's: WATER SANITARY STORM

CURB FROM PROPERTY LINE 4.877 m PAVEMENT WIDTH 10.363 m


B.C. HYDRO O/H UNDERGROUND CONNECTION

B.C. TELEPHONE O/H UNDERGROUND CONNECTION


INLAND GAS 1.524 m FROM R IN LANE.

Information Sheets:

Comments: WITH THAW WIRE.

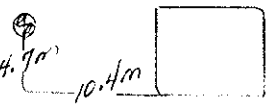

SITE PLAN N.T.S.

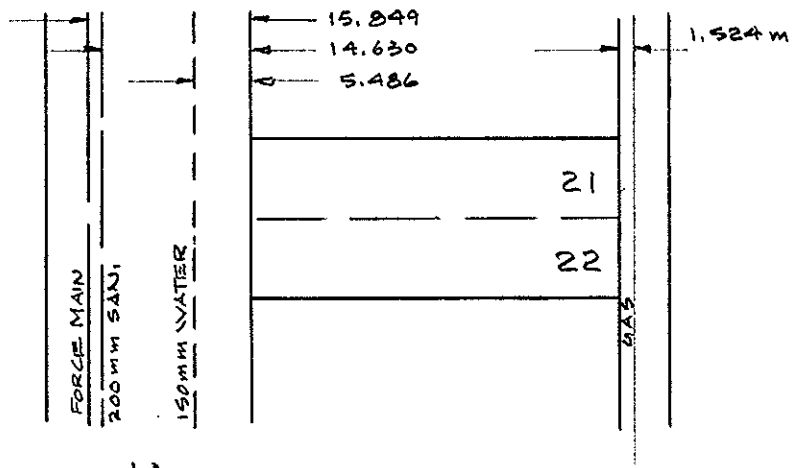

MOFFAT ST.