

**City of Prince George
HISTORY SHEET**

008014131
949

SHEET NUMBER _____ Roll Number _____

Legal: LOT'S 19-20 BLOCK 80 D.L. 937 PLAN 752

Address: 258 MOFFAT ST.

Sanitary Connection: # 3180 SIZE 100 MM MATERIAL A.C. INV. 602.451 CONNECTED

Water Connection # 3027 SIZE 20 MM MATERIAL CU. METER CONNECTED

Storm Connection: # _____ SIZE _____ MATERIAL _____ INV. _____ CONNECTED

Cash Receipt No's: WATER _____ SANITARY _____ STORM _____

CURB FROM PROPERTY LINE 4.877 m PAVEMENT WIDTH 10.363 m


B.C. HYDRO O/H UNDERGROUND CONNECTION

B.C. TELEPHONE O/H UNDERGROUND CONNECTION


INLAND GAS 1.524 m FROM R IN LANE

Information Sheets: _____

Comments: WITH THAW WIRE.

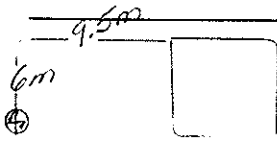

SITE PLAN N.T.S.

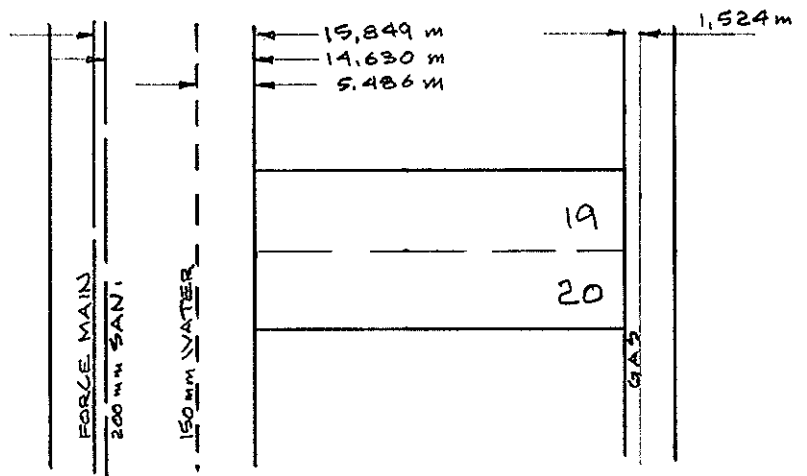

MOFFAT ST.

