

**City of Prince George
HISTORY SHEET**

009887881 D
J0804973-0

SHEET NUMBER

Roll Number

Legal: LOT'S 1-4D BLOCK 7B D.L. 937 PLAN 752,20595

Address: 291 N. NICHOLSON ST.

Sanitary Connection: # 3316 SIZE 100mm MATERIAL A.C. INV. 602.164 CONNECTED

Water Connection # 3312 SIZE 20mm MATERIAL CU. METER CONNECTED

Storm Connection: # SIZE MATERIAL INV. CONNECTED

Cash Receipt No's: WATER SANITARY STORM

CURB FROM PROPERTY LINE 4.877m PAVEMENT WIDTH 10.363m


B.C. HYDRO 0/H UNDERGROUND CONNECTION

B.C. TELEPHONE 0/H UNDERGROUND CONNECTION

INLAND GAS 1.524m FROM WEST SIDE IN LANE

Information Sheets:

Comments: WITH THAW WIRE.

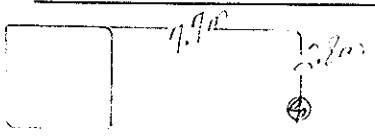

SITE PLAN N.T.S.

