

**City of Prince George
HISTORY SHEET**

008015031

SHEET NUMBER

Roll Number

040

Legal: LOT'S 13-14 BLOCK 79 D.L. 937 PLAN 752

Address: 3575 2nd AVE.

Sanitary Connection: # 3285 SIZE 100mm MATERIAL A.C. INV. 602.926 CONNECTED

Water Connection # 3318 SIZE 20mm MATERIAL C.U. METER CONNECTED

Storm Connection: # SIZE MATERIAL INV. CONNECTED

Cash Receipt No's: WATER SANITARY STORM

CURB FROM PROPERTY LINE 4.877m PAVEMENT WIDTH 10.363m

B.C. HYDRO O/H UNDERGROUND CONNECTION

B.C. TELEPHONE O/H UNDERGROUND CONNECTION



INLAND GAS 1.524m FROM R IN LANE.

Information Sheets:

Comments: WITH THAW WIRE.

SITE PLAN N.T.S.

2nd AVE.

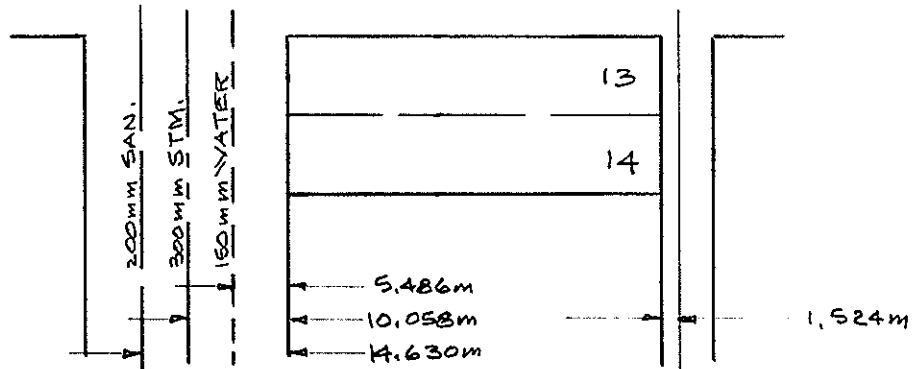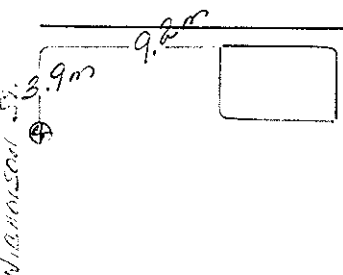

N. NICHOLSON ST.