

City of Prince George
HISTORY SHEET

308015/2

SHEET NUMBER

PID #

121

Legal: LOTS 3-4 BLOCK 80 D.L. 937 PLAN 752

Address: 281 LYON ST.

Sanitary Connection: # 3353 SIZE 100 mm MATERIAL A.C. INV. 599.604 CONNECTED

Water Connection: # 3021 SIZE 20 mm MATERIAL CU. METER CONNECTED

Storm Connection: # SIZE mm MATERIAL INV. CONNECTED

Cash Receipt No's: WATER SANITARY STORM

CURB FROM PROPERTY LINE 4.877 m PAVEMENT WIDTH 10.363 m

B.C. HYDRO 0/H UNDERGROUND CONNECTION



B.C. TELEPHONE 0/H UNDERGROUND CONNECTION

INLAND GAS 1.524 m FROM WEST SIDE OF LANE.

Information Sheets:

Comments: WITH THAW WIRE.

THE INFORMATION CONTAINED HEREIN IS FOR INTERNAL USE ONLY.
NOT TO BE RELIED UPON UNLESS CONFIRMED BY SITE INSPECTION AND/OR INVESTIGATION

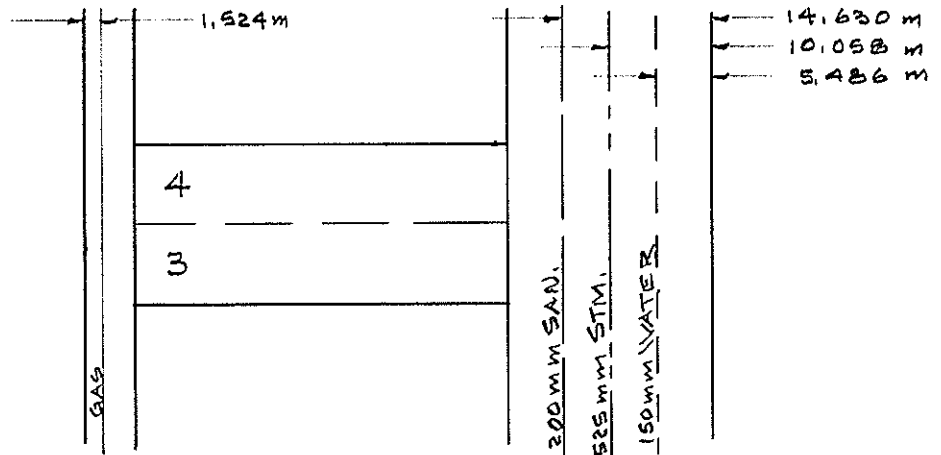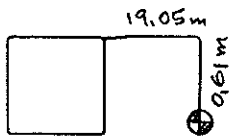

LYON ST.