

# City of Prince George HISTORY SHEET

008015887

SHEET NUMBER **N<sup>o</sup> 1470** Roll Number **309**

Legal: LOT'S **9, 10** BLOCK **71** D.L. **937** PLAN **752**

Address: **321 LYON STREET**

Sanitary Connection: # **5408** SIZE **4"** MATERIAL **A.C.S.** INV. **CONNECTED**

Water Connection # **1436** SIZE **3/4"** MATERIAL **COPPER** METER **CONNECTED**

Storm Connection: #  SIZE  MATERIAL  INV.  **CONNECTED**

Cash Receipt No's: WATER  SANITARY  STORM

CURB FROM PROPERTY LINE  PAVEMENT WIDTH

B.C. HYDRO  UNDERGROUND CONNECTION



B.C. TELEPHONE  UNDERGROUND CONNECTION

INLAND GAS

Information Sheets:

Comments:

SITE PLAN N.T.S.

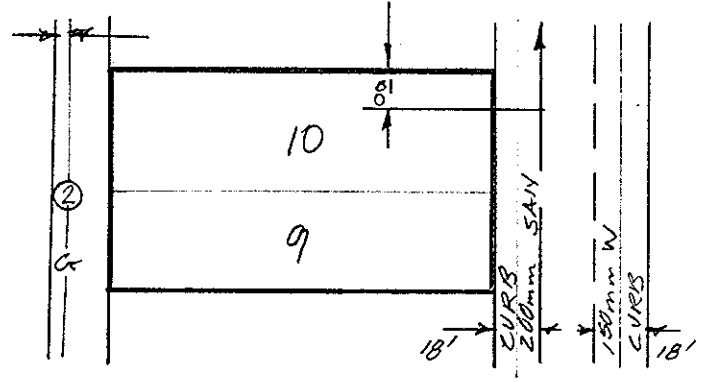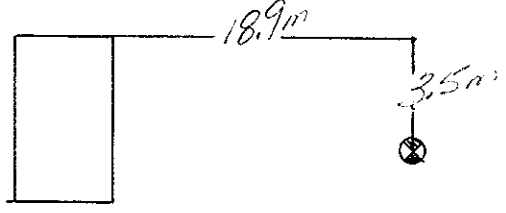

LYON ST

