

**City of Prince George
HISTORY SHEET**

308015350

SHEET NUMBER

Roll Number

368

Legal: LOT'S 17-18 BLOCK 79 D.L. 937 PLAN 752

Address: 236 N. NICHOLSON ST.

Sanitary Connection: # 3283 SIZE 100mm MATERIAL A.C. INV. 602.317 CONNECTED

Water Connection # 3316 SIZE 20mm MATERIAL C.U. METER CONNECTED

Storm Connection: # SIZE MATERIAL INV. CONNECTED

Cash Receipt No's: WATER SANITARY STORM

CURB FROM PROPERTY LINE 4.877 m PAVEMENT WIDTH 10.363 m

B.C. HYDRO 0/H UNDERGROUND CONNECTION

B.C. TELEPHONE 0/H UNDERGROUND CONNECTION


INLAND GAS 1.524 m FROM R IN LANE.

Information Sheets:

Comments: WITH THAW WIRE.



SITE PLAN N.T.S.

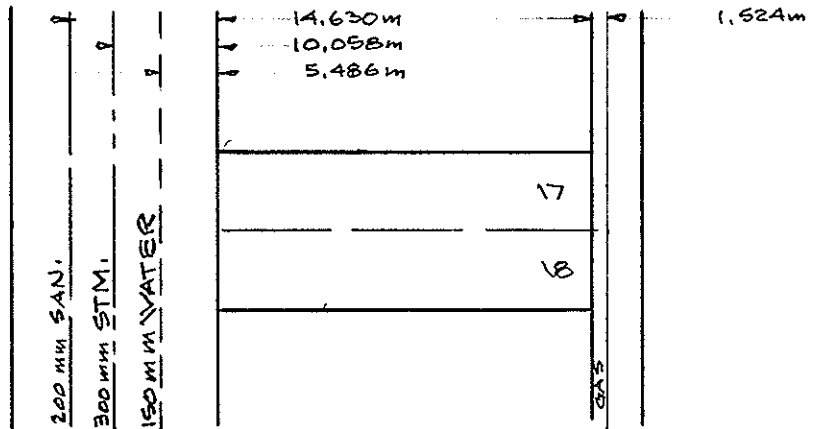

N. NICHOLSON ST.