

**City of Prince George
HISTORY SHEET**

30.00
9.80
8.10

SHEET NUMBER _____ PID # _____

Legal: LOTS 6-7-8 BLOCK 73 D.L. 937 PLAN 752

Address: 341 N. NICHOLSON ST.

Sanitary Connection: # 3244 SIZE 100 mm MATERIAL A.C. INV. 602.043 CONNECTED

Water Connection: # 3295 SIZE 20 mm MATERIAL CU. METER _____ CONNECTED

Storm Connection: # _____ SIZE _____ mm MATERIAL _____ INV. _____ CONNECTED _____

Cash Receipt No's: WATER _____ SANITARY _____ STORM _____

CURB FROM PROPERTY LINE 4.877 m PAVEMENT WIDTH 10.363 m

B.C. HYDRO 0/H UNDERGROUND CONNECTION _____




B.C. TELEPHONE 0/H UNDERGROUND CONNECTION _____

INLAND GAS 1.524 m FROM WEST SIDE OF LANE.

Information Sheets: _____

Comments: WITH THAW WIRE.

**THE INFORMATION CONTAINED HEREIN IS FOR INTERNAL USE ONLY.
NOT TO BE RELIED UPON UNLESS CONFIRMED BY SITE INSPECTION AND/OR INVESTIGATION**

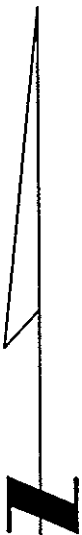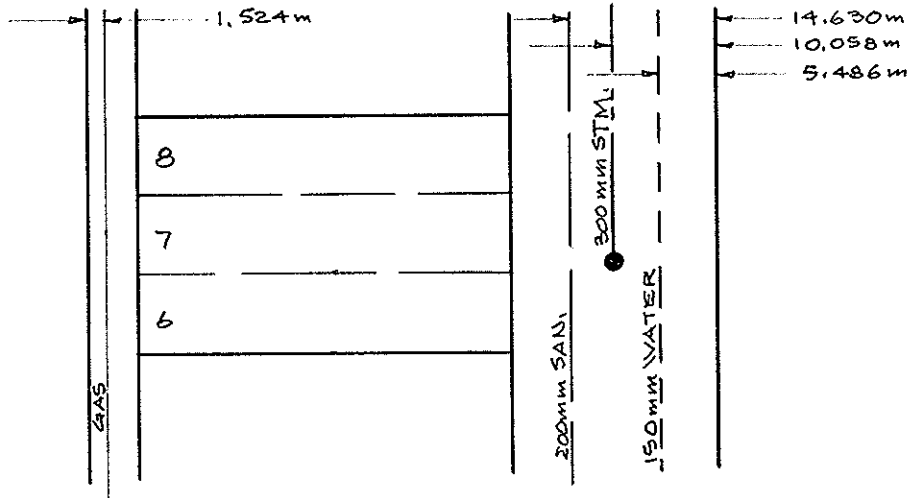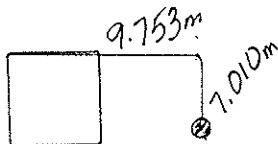

N. NICHOLSON ST.