

**City of Prince George
HISTORY SHEET**

008056555
786

SHEET NUMBER _____ Roll Number _____

Legal: LOT'S 17-18 BLOCK 82 D.L. 937 PLAN 752

Address: 242 KELLY ST.

Sanitary Connection: # 3320 SIZE 100 mm MATERIAL A.C. INV. 597.169 CONNECTED

Water Connection # 3344 SIZE 20 mm MATERIAL C.U. METER CONNECTED

Storm Connection: # _____ SIZE _____ MATERIAL _____ INV. _____ CONNECTED

Cash Receipt No's: WATER _____ SANITARY _____ STORM _____

CURB FROM PROPERTY LINE 4.877 m PAVEMENT WIDTH 10.363 m


B.C. HYDRO O/H UNDERGROUND CONNECTION

B.C. TELEPHONE O/H UNDERGROUND CONNECTION


INLAND GAS 1.524 m FROM R. IN LANE.

Information Sheets: _____

Comments: WITH THAW WIRE.

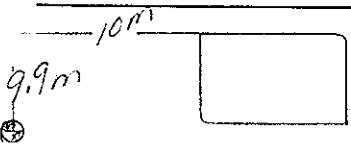

SITE PLAN N.T.S.

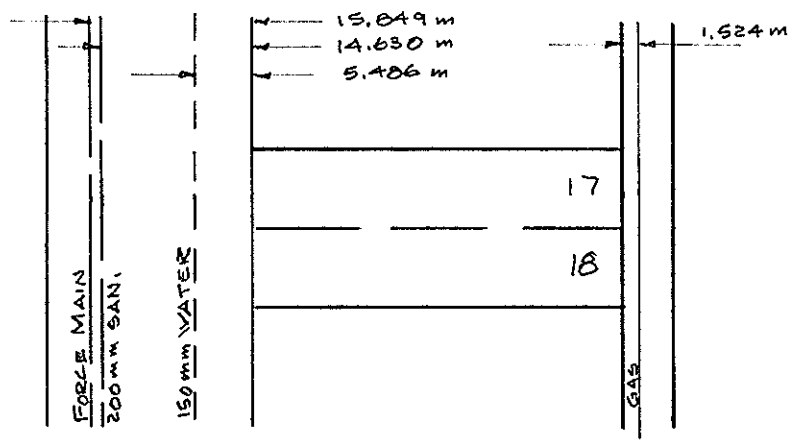

KELLY ST.