

**City of Prince George  
HISTORY SHEET**

S  
008036654  
713

SHEET NUMBER \_\_\_\_\_ Roll Number \_\_\_\_\_

Legal: LOT'S 14-18 BLOCK 83 D.L. 937 PLAN 152

Address: 258. E. CENTRAL

Sanitary Connection: # 3023 SIZE 100 mm MATERIAL A.L. INV. \_\_\_\_\_ CONNECTED

Water Connection # 3182 SIZE 20 mm MATERIAL C.U. METER \_\_\_\_\_ CONNECTED

Storm Connection: # \_\_\_\_\_ SIZE \_\_\_\_\_ MATERIAL \_\_\_\_\_ INV. \_\_\_\_\_ CONNECTED

Cash Receipt No's: WATER \_\_\_\_\_ SANITARY 512 STORM \_\_\_\_\_

CURB FROM PROPERTY LINE \_\_\_\_\_ PAVEMENT WIDTH \_\_\_\_\_


B.C. HYDRO O/H UNDERGROUND CONNECTION \_\_\_\_\_

B.C. TELEPHONE O/H UNDERGROUND CONNECTION \_\_\_\_\_

INLAND GAS AS SHOWN

Information Sheets: WITH THAW WIRE

Comments: The information contained herein is for internal use only. Not to be relied upon unless confirmed by site inspection and/or investigation.

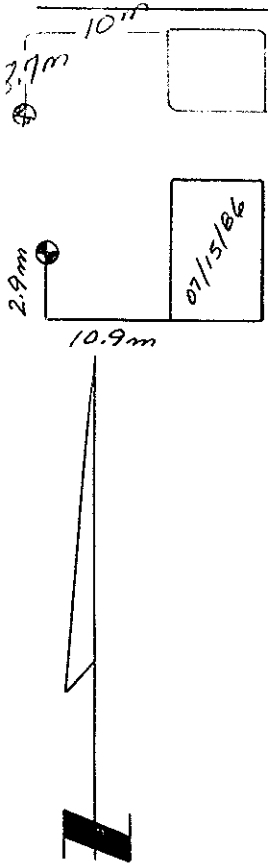

SITE PLAN N.T.S.

