

City of Prince George HISTORY SHEET

SHEET NUMBER **Nº 2399** Roll Number **008047928**

Legal: LOT'S **10** BLOCK **632** PLAN **25006**

Address: **4560 GISCOME ROAD**

Sanitary Connection: # SIZE MATERIAL INV. CONNECTED

Water Connection # SIZE MATERIAL METER CONNECTED

Storm Connection: # SIZE MATERIAL INV. CONNECTED

Cash Receipt No's: WATER SANITARY STORM

CURB FROM PROPERTY LINE PAVEMENT WIDTH

B.C. HYDRO UNDERGROUND CONNECTION


B.C. TELEPHONE UNDERGROUND CONNECTION

INLAND GAS

Information Sheets:

Comments:

SITE PLAN N.T.S.

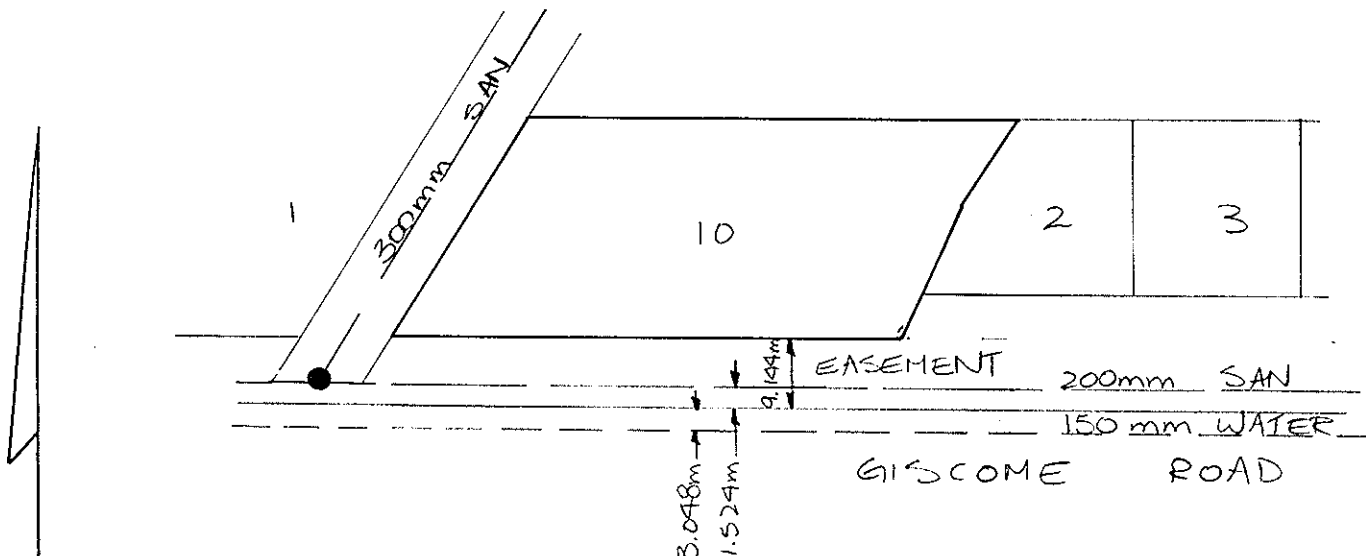

NO WATER OR SAN LOCATIONS