



City of Prince George
History Sheet

PID:	008065748
SD/MU:	
WO:	

Civic Address: 9780 Willowdale Rd
9839 Penn Rd

Legal Description: Lot: 8 District Lot: 751 Plan: 24996 except Plan EPP80803


Service Type	Diameter (mm)	Material	Invert Elev at main (m)	Invert Elev at property line (m)	Invert Depth at service end (m)	Distance into property (m)	Installation Date
Sanitary	150mm	PVC	-	576.77	3.95	20.00	December 1976
Water	150mm	PVC	-	-	-	20.40	December 1976
Storm	250mm	PVC	-	576.32	4.40	21.00	December 1976

Service Connection Location	Sanitary (m)	Storm (m)
150mm Sanitary is connected to San MH4726	-	
250mm Storm service is connected to Stm Mh1144		

Power	Size	Communications	Size	Cable	Size	Gas	Size
BC Hydro	-	Telus	-	Shaw	-	FortisBC	-
Overhead Service		Overhead Service		Overhead Service			

Installed by:	Survey Date:	-
Comments: Sanitary and Storm services confirmed September 29, 2017		

NOT TO SCALE The information contained herein is for internal use only.
Not to be relied on unless confirmed by site inspection and/or investigation.

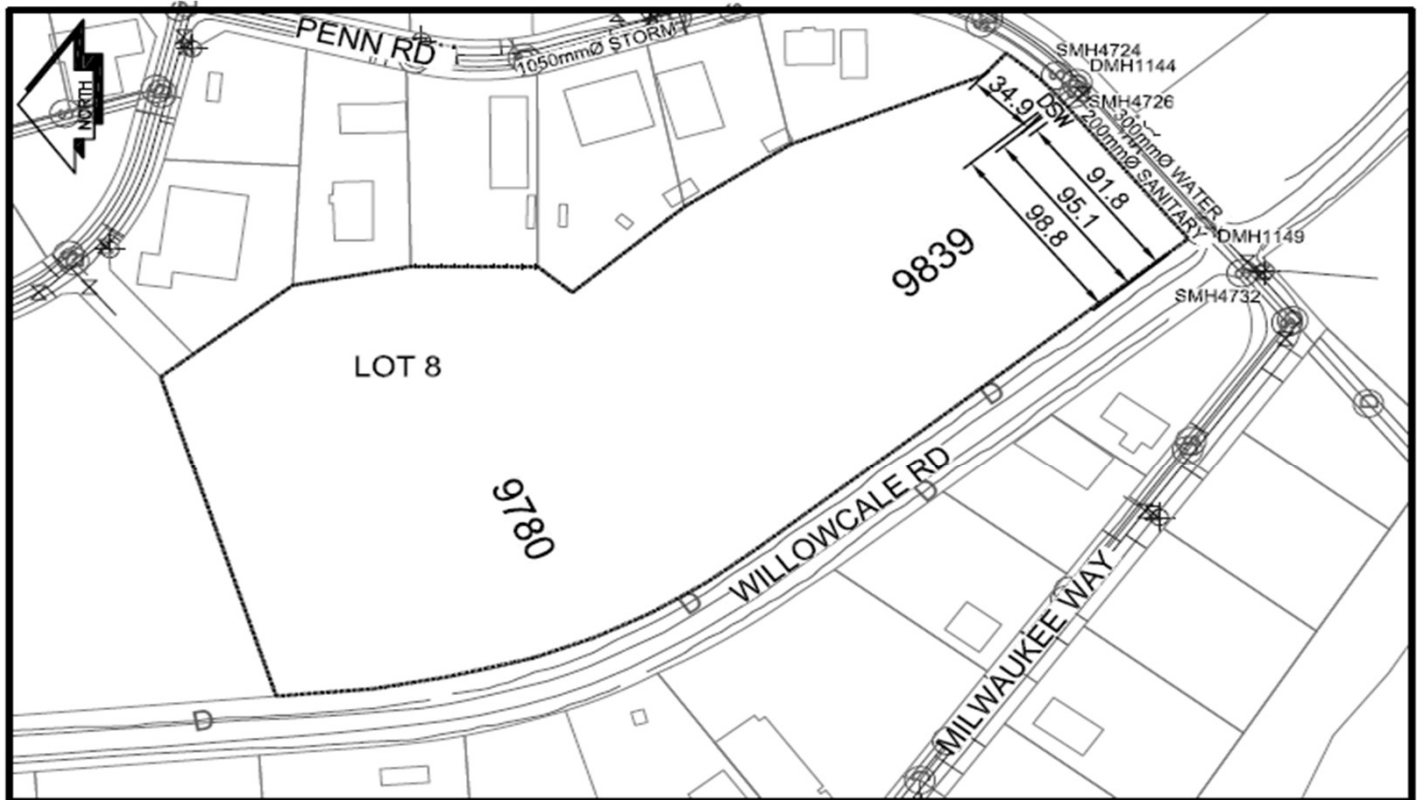

LEGEND:		
CS	CURB STOP	WATER SERVICE
CO	CLEAN OUT	SANITARY SERVICE
WV	WATER VALVE	FIRE HYDRANT
		STORM SERVICE
		GAS
		ENCUMBRANCE

NOT TO SCALE