

**City of Prince George
HISTORY SHEET**

208-065-986
934

SHEET NUMBER _____ PID # _____

Legal: LOTS 9-10 BLOCK 83 D.L. 937 PLAN 752

Address: 221 JOHNSON ST.

Sanitary Connection: # 3425 SIZE 100 mm MATERIAL A.C. INV. 595,105 CONNECTED

Water Connection: # 3389 SIZE 20 mm MATERIAL CU. METER CONNECTED

Storm Connection: # _____ SIZE _____ mm MATERIAL _____ INV. _____ CONNECTED

Cash Receipt No's: WATER _____ SANITARY _____ STORM _____

CURB FROM PROPERTY LINE 4.877m PAVEMENT WIDTH 10.363m

B.C. HYDRO O/H UNDERGROUND CONNECTION



B.C. TELEPHONE O/H UNDERGROUND CONNECTION

INLAND GAS 1.524 m FROM WEST SIDE OF LANE.

Information Sheets: _____

Comments: WITH THAW WIRE.

**THE INFORMATION CONTAINED HEREIN IS FOR INTERNAL USE ONLY.
NOT TO BE RELIED UPON UNLESS CONFIRMED BY SITE INSPECTION AND/OR INVESTIGATION**

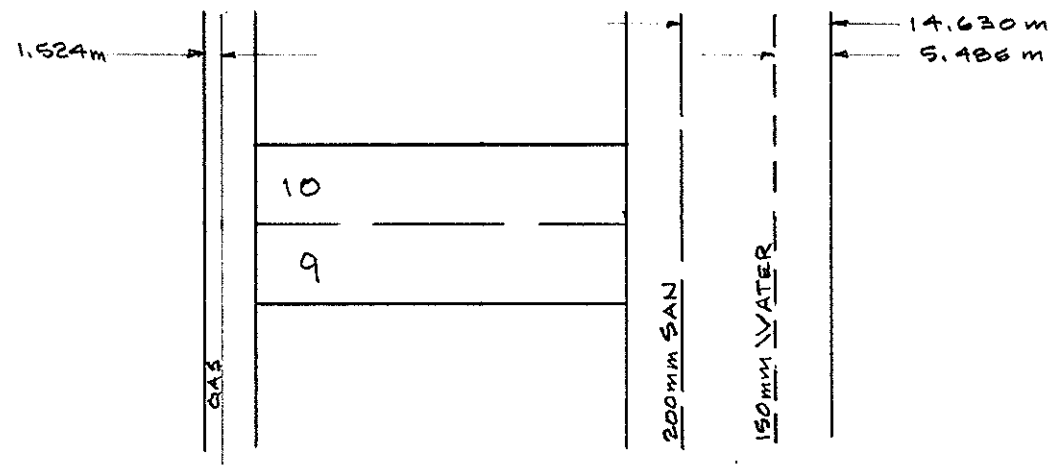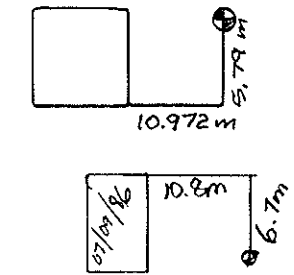

JOHNSON ST.