

**City of Prince George
HISTORY SHEET**

008065-993

SHEET NUMBER

Roll Number

008065-001

Legal: LOT'S 15-16 BLOCK 82 D.L. 937 PLAN 752

Address: 226 KELLY ST.

Sanitary Connection: # 3061 SIZE 100 mm MATERIAL A.C. INV. 597.099 CONNECTED

Water Connection # 3218 SIZE 20 mm MATERIAL C.U. METER CONNECTED

Storm Connection: # SIZE MATERIAL INV. CONNECTED

Cash Receipt No's: WATER SANITARY STORM

CURB FROM PROPERTY LINE 4.877 m PAVEMENT WIDTH 10.363 m


B.C. HYDRO O/H UNDERGROUND CONNECTION

B.C. TELEPHONE O/H UNDERGROUND CONNECTION

INLAND GAS 1,524 m FROM R IN LANE.

Information Sheets:

Comments: WITH THAW WIRE.

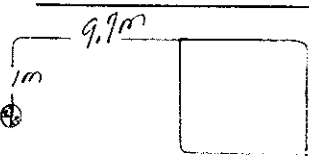

SITE PLAN N.T.S.

