



City of Prince George
History Sheet

PID:	008068381
SD/MU:	
WO:	

Civic Address: 4762 Giscome Road

Legal Description: Lot: 8 District Lot: 632 Plan: 25006


Service Type	Diameter (mm)	Material	Invert Elev at main (m)	Invert Elev at property line (m)	Invert Depth at service end (m)	Distance into property (m)	Installation Date
Sanitary	100mm	AC	-	-	1.37	-	September 1978
Water	20mm	Copper	-	-	-	-	September 1978
Storm	N/A	N/A	-	-	-	-	

Service Connection Location				Sanitary (m)	Storm (m)
Distance from downstream San MH	1121	towards upstream San MH	1120	116.97	
Distance from downstream Stm MH	-	towards upstream Stm MH	-		

Power	Size	Communications	Size	Cable	Size	Gas	Size
BC Hydro	-	Telus	-	Shaw	-	FortisBC	-
Overhead Service		Overhead Service		Overhead Service			

Installed by:	Survey Date:	-
Comments: Water service location as per August 2014 locate		

NOT TO SCALE The information contained herein is for internal use only.
Not to be relied on unless confirmed by site inspection and/or investigation.

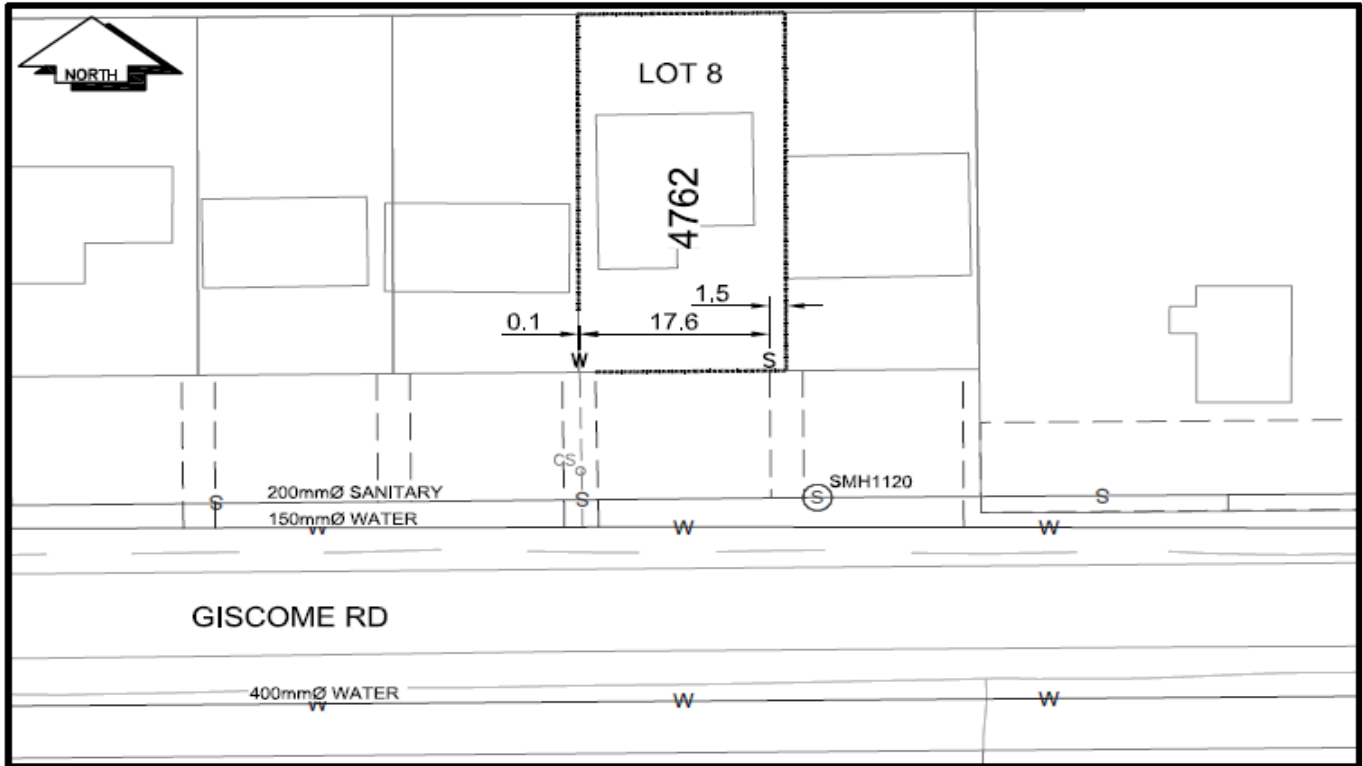

CS ^o CURB STOP	--- W WATER SERVICE	--- S SANITARY SERVICE	--- o STORM SERVICE
CO ^o CLEAN OUT	--- S SANITARY SERVICE	--- G GAS	
⊗ WATER VALVE	⊗ FIRE HYDRANT	--- ENCUMBRANCE	

NOT TO SCALE