

**City of Prince George
HISTORY SHEET**

308068488 HM

SHEET NUMBER

Roll Number

496

Legal: LOT'S 21, 22 BLOCK 84 D.L. 937 PLAN 752

Address: 274 JOHNSON STREET

Sanitary Connection: # 1922 SIZE MATERIAL INV. CONNECTED

Water Connection # 1220 SIZE 3/4" MATERIAL COPPER METER CONNECTED

Storm Connection: # SIZE MATERIAL INV. CONNECTED

Cash Receipt No's: WATER SANITARY STORM

CURB FROM PROPERTY LINE PAVEMENT WIDTH



B.C. HYDRO UNDERGROUND CONNECTION

B.C. TELEPHONE UNDERGROUND CONNECTION

INLAND GAS

Information Sheets:

Comments:

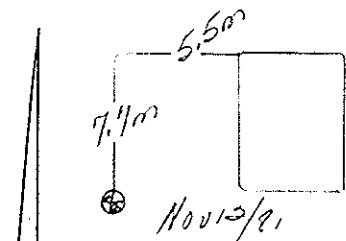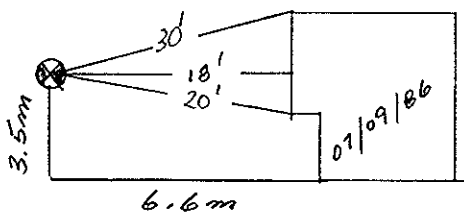

SITE PLAN N.T.S.

