



City of Prince George
History Sheet

PID:	008069221
SD/MU:	
WO:	

Civic Address: 2823 Vance Rd

Legal Description: Lot: 2 District Lot: 905 Plan: 24848


Service Type	Diameter (mm)	Material	Invert Elev at main (m)	Invert Elev at property line (m)	Invert Elev at service end (m)	Distance into property (m)	Installation Date
Sanitary	100mm	AC	-	593.70	-	-	December 1977
Water	20mm	PVC	-	-	-	-	December 1966
Storm	100mm	PVC	-	593.65	-	-	December 1977

Service Connection Location				Sanitary (m)	Storm (m)
Distance from downstream San MH	3577	towards upstream San MH	3578	30.50	
Distance from downstream Stm MH	1790	towards upstream Stm MH	1789		31.33

Power	Size	Communications	Size	Cable	Size	Gas	Size
BC Hydro	-	Telus	-	Shaw	-	FortisBC	-
Overhead Service		Overhead Service		Overhead Service		30.05	

Installed by:		Survey Date:	-
Comments:	Water, Sanitary and Storm services location confirmed on April 5, 2019		

NOT TO SCALE The information contained herein is for internal use only.
Not to be relied on unless confirmed by site inspection and/or investigation.

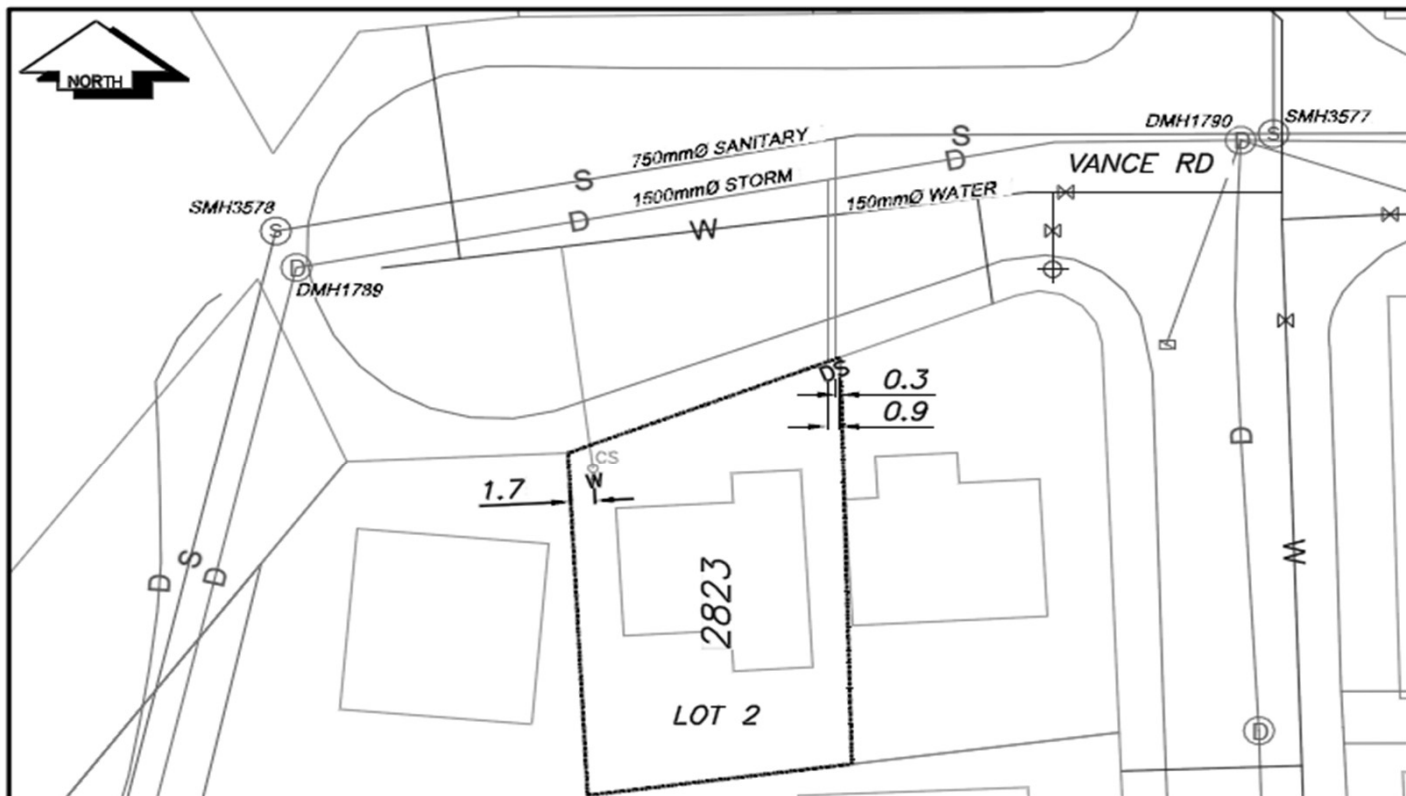

LEGEND:					
CS	CURB STOP	W	WATER SERVICE	D	STORM SERVICE
CO	CLEAN OUT	S	SANITARY SERVICE	G	GAS
⊗	WATER VALVE	⊕	FIRE HYDRANT	- - -	ENCUMBERANCE

NOT TO SCALE