

# City of Prince George HISTORY SHEET

008150265

SHEET NUMBER

Roll Number

281

Legal: LOT'S 19, 20 BLOCK 87 D.L. 937 PLAN 752

Address: 260 GILLETTE STREET

Sanitary Connection: # 7001 SIZE 4" MATERIAL TRANSITE INV. CONNECTED

Water Connection # 1236 SIZE 3/4" MATERIAL COPPER METER CONNECTED

Storm Connection: # \_\_\_\_\_ SIZE \_\_\_\_\_ MATERIAL \_\_\_\_\_ INV. CONNECTED

Cash Receipt No's: WATER \_\_\_\_\_ SANITARY 282 STORM \_\_\_\_\_

CURB FROM PROPERTY LINE \_\_\_\_\_ PAVEMENT WIDTH \_\_\_\_\_

B.C. HYDRO \_\_\_\_\_ UNDERGROUND CONNECTION \_\_\_\_\_


B.C. TELEPHONE \_\_\_\_\_ UNDERGROUND CONNECTION \_\_\_\_\_

INLAND GAS \_\_\_\_\_


Information Sheets: \_\_\_\_\_

Comments: \_\_\_\_\_

SITE PLAN N.T.S.

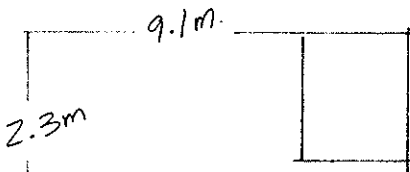

GILLETTE ST

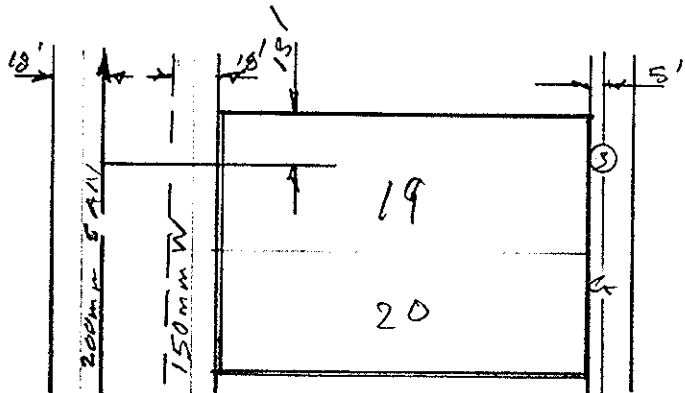

# REPORT TO RECORDS

## SEWER SERVICE INFORMATION

Lot No. \_\_\_\_\_ Block \_\_\_\_\_ D.L. \_\_\_\_\_


Address 260 GILLETTE

Size of Connection  100mm  150mm  200mm  Other \_\_\_\_\_

Type of Connection  Transite  PVC  Other \_\_\_\_\_

Type of Cap  Transite  Cast Iron

### LOCATION SKETCH

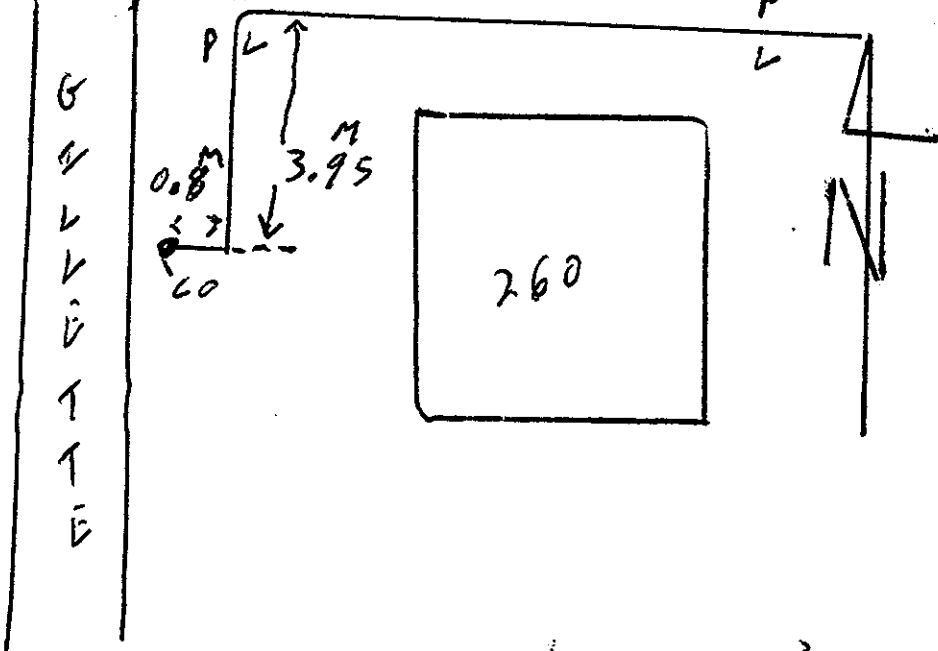

Field Location By A. ST. CROIX Date MAY 3 1911

Checked by Foreman - Sewer Division \_\_\_\_\_